

MISSISSIPPI DEPARTMENT OF NATURAL RESOURCES
Bureau of Land and Water Resources

P.O. Box 10631
Jackson, Mississippi 39209
WATER WELL DRILLERS LOG

COUNTY WELL LOCATED Washington		
WELL NUMBER B 49	CODED <input checked="" type="checkbox"/>	PERMIT NUMBER
146 B		NAME OF DRILLING FIRM IRRIGATION Equipment
DATE WELL COMPLETED 10-27-87		IND. ANOLA, MS

NAME & MAILING ADDRESS OF LANDOWNER Percy Barnett			
100 PENINSULA DRIVE			
Leland, MS 38751			
WELL LOCATION:	SEC	TOWNSHIP	RANGE
	25	19	7
		N	E
		S	W
DISTANCE	DIRECTION	NEAREST TOWN	
4 Miles	North	of Leland	
OTHER LANDMARK			
WELL PURPOSE: Home, Irrigation, Municipal, Industrial, Fish Pond, etc. IRRIGATION			

PUMP DATA		
PUMP TYPE (Circle One): Submersible, <u>Turbine</u> , Jet, Flowing Well, Other (Describe) _____		
POWER TYPE (Circle One): Electric, Tractor, <u>Diesel</u> , Gasoline, Butane, Other (Describe) _____		
Pump Capacity (GPM)	No. of Stages	Setting Depth
2000	1	50 FT.
PUMP TEST		
Well yielded _____ GPM with a drawdown of _____ ft. after _____ hours of pumping		

WELL DATA		
Well Depth 108	Casing Diameter (In.) 16	Casing Length (Ft.) 68
Type of Casing steel	Hole Depth 108	Depth to Static Water Level 30'
TYPE OF COMPLETION: (Circle One or More): <u>Gravel Packed</u> , Underreamed, Telescoped, Natural Development, Open Hole, Other (Describe) _____		
Top of Lap Pipe or Reduction in Casing		
FEET	IF TELESCOPED OR MORE THAN ONE SCREEN: USE BACK PAGE	

LOG DATA	
TYPE OF LOG RUN (Circle One): No Log Run, Electric, Gamma Ray, Density, Sonic, Neutron, Other (Describe) _____	
Name of Organization Running Log	


SCREEN DATA		
Diameter - Inches 16	Length - Feet 40	Slot Size - Inches .060
Screen Type steel	Depth to Bottom - Feet 40	

GEOLOGIC DATA (Office Use Only)			
Surface Elev.	Geologic Unit	Unit Thickness	Depth to Top
Subs. SWL	Date	Analysis	Aquifer Test
Driller's Remarks			

DESCRIPTION OF FORMATIONS ENCOUNTERED	FROM	TO	FORMATIONS (Continued)	FROM	TO
clay	0	15	RECEIVED		
Fine sand	15	45			
Coarse sand with gravel	45	108			
			OCT 29 1987		
			Department of Natural Resources Bureau of Land & Water Resources		
			IF MORE SPACE IS NEEDED, USE BACK		

If well telescopes please sketch and show depths.

GROUND LEVEL

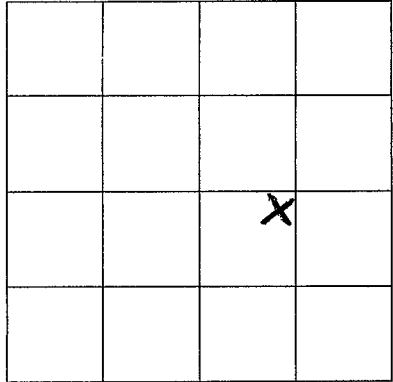

SECTION 25

Please indicate well location X.

ADDITIONAL INFORMATION

Lined area for additional information.

If more than one screen, show location of each on sketch.