

MISSISSIPPI DEPARTMENT OF ENVIRONMENTAL QUALITY

Office of Land and Water Resources

P. O. Box 10631
Jackson, MS 39289-0631
WATER WELL DRILLERS LOG

COUNTY WELL LOCATED <u>Washington</u>	
WELL NUMBER <u>B 55-1</u>	CODED <input checked="" type="checkbox"/>
DATE WELL COMPLETED <u>9-5-98</u>	

PERMIT NUMBER
NAME OF DRILLING FIRM <u>Schudco Ltd</u>

NAME & MAILING ADDRESS OF LANDOWNER <u>Jay Seeburn</u>			
<u>Ne胰腺 Rd</u>			
<u>Leland MS.</u>			
WELL LOCATION:	SEC	TOWNSHIP	RANGE
	<u>24</u>	<u>19</u>	<u>7</u>
		<u>N</u> S	<u>E</u> W
DISTANCE	DIRECTION	NEAREST TOWN	
<u>5</u> Miles	<u>North</u>	of <u>Leland</u>	
OTHER LANDMARK			
WELL PURPOSE: <input checked="" type="checkbox"/> Home Irrigation, <input type="checkbox"/> Municipal, <input type="checkbox"/> Industrial, <input type="checkbox"/> Fish Pond, etc.			

PUMP DATA		
PUMP TYPE (Circle One): <input checked="" type="checkbox"/> Submersible, <input type="checkbox"/> Turbine, <input type="checkbox"/> Jet, <input type="checkbox"/> Flowing Well, Other (Describe) _____		
POWER TYPE (Circle One): <input checked="" type="checkbox"/> Electric, <input type="checkbox"/> Tractor, <input type="checkbox"/> Diesel, <input type="checkbox"/> Gasoline, <input type="checkbox"/> Butane, Other (Describe) _____ H/P <u>1 1/2</u>		
Pump Capacity (GPM) <u>28</u>	No. of Stages	Setting Depth <u>100</u> FT.
PUMP TEST		
Well yielded _____ GPM with a drawdown of _____ ft. after _____ hours of pumping		

WELL DATA		
Well Depth <u>500</u>	Casing Diameter (In.) <u>4 1/2</u>	Casing Length (Ft.) <u>470</u>
Type of Casing <u>pvc</u>	Hole Depth <u>500</u>	Depth to Static Water Level <u>31</u>

LOG DATA	
TYPE OF LOG RUN (Circle One): Electric, Gamma Ray, Density, Sonic, <input checked="" type="checkbox"/> No Log Run, Neutron, Other (Describe) _____	
Name of Organization Running Log	

TYPE OF COMPLETION: (Circle One or More):
Gravel Packed, Underreamed, Telescoped,
 Natural Development, Open Hole, Other
(Describe)

GEOLOGIC DATA (Office Use Only)			
Surface Elev.	Geologic Unit	Unit Thickness	Depth to Top
Subs. SWL	Date	Analysis	Aquifer Test

WELL GROUTED TO A DEPTH OF 10 FEET
Type Grout (circle one): Cement, Bentonite, or Mix

SCREEN DATA		
Diameter - Inches <u>2</u>	Length - Feet <u>30</u>	Slot Size - Inches <u>.008</u>
Screen Type <u>pvc</u>	Depth to Bottom - Feet <u>500</u>	


Driller's Remarks			
Top of Lap Pipe or Reduction in Casing			
FEET		IF TELESCOPED OR MORE THAN ONE SCREEN: USE BACK PAGE	

DESCRIPTION OF FORMATIONS ENCOUNTERED	FROM	TO
<u>Gunbo</u>	<u>0</u>	<u>20</u>
<u>Sand + gravel</u>	<u>20</u>	<u>165</u>
<u>clay</u>	<u>165</u>	<u>260</u>
<u>Sandy shell</u>	<u>260</u>	<u>400</u>
<u>sand</u>	<u>400</u>	<u>500</u>

FORMATIONS (Continued)	FROM	TO
RECEIVED		
OCT 05 1998		
Dept of Environmental Quality Office of Land & Water Resources		
IF MORE SPACE IS NEEDED, USE BACK		

If well telescopes please sketch and show depths.

GROUND LEVEL

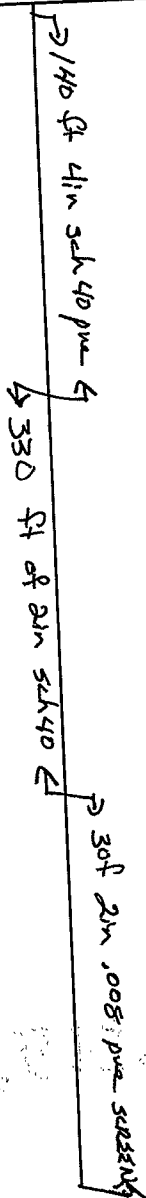

		X	

SECTION 24

Please indicate well location X.

ADDITIONAL INFORMATION

If more than one screen,
show location of each on sketch.