

MISSISSIPPI DEPARTMENT OF ENVIRONMENTAL QUALITY
Office of Land and Water Resources

P. O. Box 10631
Jackson, MS 39289-0631
WATER WELL DRILLERS LOG

COUNTY WELL LOCATED <i>Washington</i>	
WELL NUMBER <i>B-11</i>	CODED
DATE WELL COMPLETED <i>6-25-01</i>	

33-28-00 90-52-56

PERMIT NUMBER
NAME OF DRILLING FIRM <i>Schudco Ltd</i>

NAME & MAILING ADDRESS OF LANDOWNER <i>L + S Fish Farms</i>		
<i>Napanee Rd.</i>		
<i>LeLand Ms 39756</i>		
WELL LOCATION: SEC	TOWNSHIP	RANGE
<i>SW/NW 25</i>	<i>19</i>	<i>7</i>
DISTANCE	DIRECTION	NEAREST TOWN
<i>5</i> Miles	<i>North</i>	<i>LeLand</i>
OTHER LANDMARK		
WELL PURPOSE: Home, Irrigation, Municipal, Industrial, <u>Fish Pond</u> , etc.		

PUMP DATA		
PUMP TYPE (Circle One): <u>Submersible</u> Turbine, Jet, Flowing Well, Other (Describe) _____		
POWER TYPE (Circle One): <u>Electric</u> Tractor, Diesel, Gasoline, Butane, Other (Describe) _____ H/P <i>20</i>		
Pump Capacity (GPM)	No. of Stages	Setting Depth
	<i>1</i>	<i>60</i> FT.
PUMP TEST		
Well yielded _____ GPM with a drawdown of _____ ft. after _____ hours of pumping		

WELL DATA		
Well Depth <i>100</i>	Casing Diameter (In.) <i>10</i>	Casing Length (Ft.) <i>60</i>
Type of Casing <i>pvc</i>	Hole Depth <i>100</i>	Depth to Static Water Level
TYPE OF COMPLETION: (Circle One or More): <u>Gravel Packed</u> , Underreamed, Telescoped, Natural Development, Open Hole, Other (Describe) _____		
WELL GROUTED TO A DEPTH OF _____ FEET Type Grout (circle one): Cement, Bentonite, or Mix		

LOG DATA	
TYPE OF LOG RUN (Circle One): <u>No Log Run</u> , Electric, Gamma Ray, Density, Sonic, Neutron, Other (Describe) _____	
Name of Organization Running Log	

SCREEN DATA		
Diameter - Inches <i>10</i>	Length - Feet <i>40</i>	Slot Size - Inches <i>.032</i>
Screen Type <i>pvc</i>	Depth to Bottom - Feet <i>100</i>	

GEOLOGIC DATA (Office Use Only)			
Surface Elev.	Geologic Unit	Unit Thickness	Depth to Top
Subs. SWL	Date	Analysis	Aquifer Test
Driller's Remarks			
Top of Lap Pipe or Reduction in Casing			
FEET		IF TELESCOPED OR MORE THAN ONE SCREEN: USE BACK PAGE	


DESCRIPTION OF FORMATIONS ENCOUNTERED	FROM	TO
<i>clay</i>	<i>0</i>	<i>20</i>
<i>med sand</i>	<i>20</i>	<i>50</i>
<i>course sand - p-gravel</i>	<i>50</i>	<i>80</i>
<i>course sand, p-gravel + gravel</i>	<i>80</i>	<i>100</i>

FORMATIONS (Continued)	FROM	TO

REC'D SEP 28 2001

If well telescopes please
sketch and show depths.

GROUND LEVEL

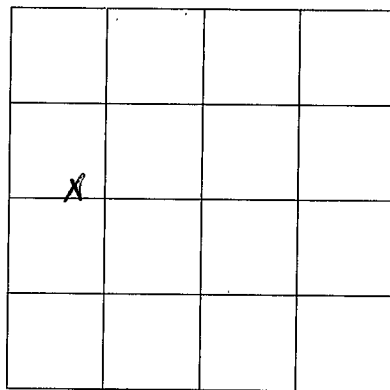

SECTION 25

Please indicate well location X.

ADDITIONAL INFORMATION

If more than one screen,
show location of each on sketch.