

STATE WELL REPORT

Part I

Driller's Log

Mississippi Department of Environmental Quality
Office of Land and Water Resources
P.O. Box 2309
Jackson, MS 39225-2309
(601)961-5210
(601)360-0535 (fax)

For Office Use Only:

Well #: B116
Aquifer: _____
E-Log #: _____

County: Washington
Permit #: GW-47700
Driller: Richard Fastea
Date drilling completed: 10-24-13

State Law requires that this report be prepared by the license holder responsible for the work and filed with the Department at the above address within 30 days of completion of drilling of the well or borehole.

Well Owner Information <small>Well 4 (Landowner if borehole is not for a water well)</small>	Well or Borehole Location
Owner Name: <u>JWB, MS, LLC</u>	Latitude: <u>33° 26' 39"</u> Longitude: <u>90° 58' 06"</u>
Mailing Address: <u>4424 Caroline Hwy</u>	Method of Lat/Long (check one): Conventional Survey _____ 40 Hand-held GPS <input checked="" type="checkbox"/> Survey-grade GPS _____
City: <u>Denmark</u> State: <u>MS</u> Zip Code: <u>39042</u>	USGS quad: <u>SW 1/4 SW 1/4, Sec 31, T180^{19N} R07W</u>
Telephone No. <u>(662) 347-8090</u>	<u>4.3</u> Miles <u>NW</u> of <u>Leland</u> (Distance) (Direction) (Nearest Town)

Well / Borehole Data
Date drilling started: <u>10-24-13</u> Date drilling completed: <u>10-24-13</u> Hole depth: <u>88'</u> Hole diameter: <u>26"</u>
Location of the source of any surface water used for drilling: <u>nearby ditch</u>
Method of dosing and volume of Chlorine used in drilling and development: _____
Logs run (circle all applicable): <input checked="" type="checkbox"/> No log run <input type="checkbox"/> Electric <input type="checkbox"/> Gamma Ray <input type="checkbox"/> Density <input type="checkbox"/> Sonic <input type="checkbox"/> Neutron <input type="checkbox"/> Other: _____
Name of organization running log(s): _____
Purpose of borehole (circle one): <input checked="" type="checkbox"/> Water Well <input type="checkbox"/> Geotechnical/Geological Investigation <input type="checkbox"/> Ground Source Heat Pump <input type="checkbox"/> Seismic Survey <input type="checkbox"/> Other (describe) _____
<i>If drilling is not related to water well construction, skip the remainder of this block</i>
Purpose of Well (circle all applicable): Home <input type="checkbox"/> Industrial <input type="checkbox"/> Public Supply <input checked="" type="checkbox"/> Irrigation <input type="checkbox"/> Fish Culture
Other (describe): <u>Replaces GW10873</u>
If a flowing well, method of flow regulation: Valve _____ Other (describe) _____
Static Water Level: <u>21</u> feet (above or below) land surface (circle one) Date measured: <u>10-29-13</u>
Method of measurement (circle one): Steel tape <input checked="" type="checkbox"/> Electric Tape <input type="checkbox"/> Air line <input type="checkbox"/> Other (describe) _____
Well depth: <u>84'</u> Well grouted to a depth of: <u>10</u> feet Type of grout (circle one): <input checked="" type="checkbox"/> Neat Cement <input type="checkbox"/> Bentonite Mix
Casing length: <u>49</u> feet Casing diameter: <u>16</u> inches Type of casing: <u>PVC</u>
Screen length: <u>35</u> feet Screen diameter: <u>16</u> inches Type of screen: <u>PVC</u>
Screen slot size: <u>.050</u> inches Setting depth: From <u>49</u> feet to <u>84</u> feet
Type of completion (circle all applicable): <input checked="" type="checkbox"/> Gravel packed <input type="checkbox"/> Underreamed <input type="checkbox"/> Open hole <input type="checkbox"/> Natural Development
Other (describe): _____
Top of lap pipe or reduction in casing: <u>2 1/2</u> feet
<i>If telescoped or more than one screen, describe on next page</i>

Form: OLWR-SWR-1A (4/13)


County: Washington
Permit #: GW-47700

For Office Use Only:
Well #: Bill

The sketch below only required for water wells

Description of formations encountered must be provided for all wells and boreholes, unless specifically exempted by regulations

If well telescopes, show depths on sketch.

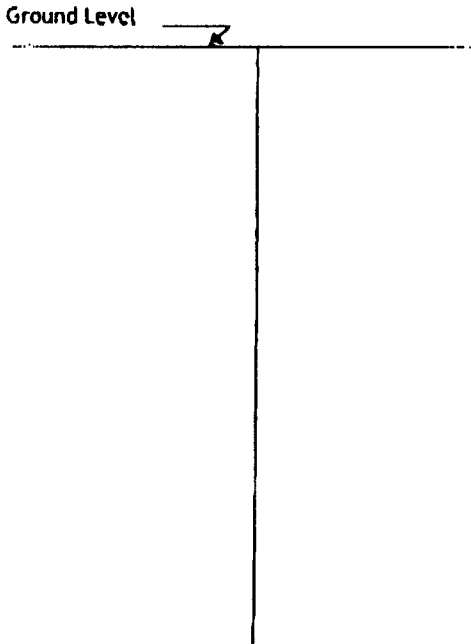

Description of Formations Encountered	From (depth)	To (depth)
Clay	Ground level	14
Red Clay & Fine Sand	14	31
Fine Sand	31	42
Medium Sand	42	45
Medium Coarse Sand	45	
& pea gravel		84
Clay	84	88

If more than one screen, show location of each on sketch

Sketch the property layout and include the following:
1) the well location
2) any permanent structures on the property that may aid in locating the well
3) any roads, power lines, or other items that may aid in locating the property and the well
4) north arrow

Landowner Name: JWB, MS, LLC / Terry Driver

I HEREBY CERTIFY that the well/borehole was drilled, constructed, and completed in accordance with all applicable requirements of the Mississippi Department of Environmental Quality and the Mississippi Department of Health regulations, if applicable, and state laws.

Print Name of Responsible Licensee and License No. Clayton Miller 0-703

Date 11-1-13

Signature of Licensee Clayton Miller

STATE WELL REPORT

Part 2

Pump Installer's Completion Report
Mississippi Department of Environmental Quality
Office of Land and Water Resources
P.O. Box 2309
Jackson, MS 39225-2309
(601)961-5210
(601) 360-0535 (fax)

County: Washington
Permit #: GW-47700
Driller: John Rybolt IV
Date completed: 10-29-13
Copy information from block on Part 1

For Office Use Only:

Well #: 13116
Aquifer: _____

This part of the report must be completed by a licensed water well contractor or a licensed pump installer. A copy of Part 1 of the report must be attached and both parts filed with the Department at the above address within 30 days of well completion.

Well Owner Information	Well Location
Owner Name: <u>JWB HAS LLC</u>	Latitude: <u>33°26'39"</u> Longitude: <u>90°58'06"</u>
Mailing Address: <u>4424 Carolina Hwy</u>	Method of Lat/Long (check one): Conventional Survey _____, USGS quad _____, Hand-held GPS <u>—</u> , Survey-grade GPS _____
<u>Denmark</u> <u>SC</u> <u>29042</u> City State Zip Code	<u>SW 1/4 SW 1/4, Sec 31 T 15N R 07W</u>
Telephone No. <u>(662) 347-8090</u>	<u>4.3</u> Miles <u>NW</u> of <u>Leland</u> (Distance) (Direction) (Nearest Town)

Pump Type (circle one)

Submersible turbine Air Lift Centrifugal Flowing Well Jet Piston Rotary Other (describe): _____

Date Pump Installed: 10-29-13 Rated Pump Capacity: _____ Gallons Per Minute

Is This Pump (circle one): New Repaired Replacement

Power Type (circle one)

Electric Diesel Gasoline Natural Gas Tractor PTO Windmill Other (describe): _____

Horse Power Rating of Motor: 40 Setting Depth: 50 feet Number of Stages: 2

Pump Test Data for Non Flowing Well

Date Well Tested: NOT TESTED Duration of Pump Test (minimum 4 hours): N/A hours

Static Water Level (A): 21 Feet Below Land Surface Pumping Water Level (B): N/A Feet Below Land Surface

Drawdown [(B) (A)]: N/A Feet Below Land Surface Test Pumping Rate: N/A Gallons Per Minute

Method of measurement (circle one): Steel tape Electric tape Air line Other (describe): _____

Pump Test Data for Flowing Well

Measured shut in head: _____ feet.

Well yielded _____ GPM with a drawdown of _____ feet after _____ hours of pumping

Meter Installation

Meter Manufacturer: _____ Meter Serial Number: _____

Meter Model Number/Name: _____ Type of Meter: _____

Totalizer Register Unit and Multiplier Factor (AF x .001, gal x 1000, etc): _____

Installation Date: _____ Meter installed by: _____

Is This Meter (circle one): New Repaired Replacement

Important: By submitting the above information you are certifying that this meter was installed to manufacturer standards. For agricultural wells, a list of approved meters is on the MDEQ website.

I HEREBY CERTIFY that the above statements are true to the best of my knowledge.

Clayton Miller 0-703 11-1-13 Clayton Miller
Print Name of Pump Installer and License No. (if applicable) Date Signature of Pump Installer

Form: OLWR-SWR-1B (1/13)