

Washington
 B 1001
 6-4-74

MISSISSIPPI
 BOARD OF WATER COMMISSIONERS
 416 North State Street
 Jackson, Mississippi 39201

WATER WELL DRILLERS LOG

June 4 1976 Schultz Drilling Washington
 date well completed firm name county well located

LANDOWNER: Claude HARR
 Rt. 2.
 GREENVILLE Miss
 (mailing address)

WELL LOCATION:
 sec 38 T 19 N R 2 E
 6 miles N/E of Owl
 (distance) (direction) (nearest town)

WELL PURPOSE: Industrial
 (home, irrigation, municipal, industrial)

- WELL COMPLETION DATA:
- (1) diameter (inches) 4 1/2"
 - (2) total depth (feet) 400
 - (3) static water level (feet) 24 below top of ground
 - (4) casing PVC (material) (depth) (size) If telescope see back.
 - (5) screen 20 (length) (depth to top) 2 PVC (size) (material)
 - (6) pump 1 (HP) 50 (yield gpm) (type power) electric
 - (7) electric log No (yes or no)
 - (organization running log)
 - (8) how well bottom plugged S/S

description of formations encountered	depth	
	from	to
Clay	0	25
sand	25	95
Clay	95	135
sand	135	150
Clay	150	190
sandy shale	190	330
SAND FINE	330	355
sand Road	355	400


RECEIVED
 AUG 24 1976

MISS. BD. OF WATER COMM.

DRILLERS REMARKS:

If well telescopes please sketch and show depths.

GROUND LEVEL

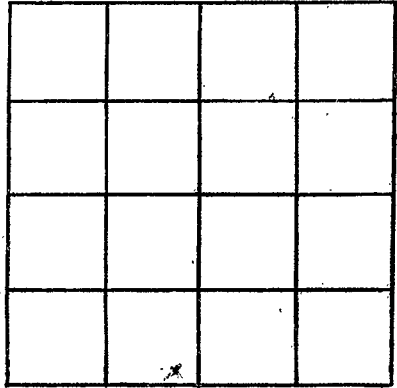

SECTION 28

Please indicate well location X.

ADDITIONAL INFORMATION

If more than one screen, show locations of each on sketch.