

WASHINGTON
B 100A
4-28-77

MISSISSIPPI
 BOARD OF WATER COMMISSIONERS
 416 North State Street
 Jackson, Mississippi 39201

WATER WELL DRILLERS LOG

BUTANE GAS CO. OF GREENWOOD

Washington

4-28-77
 date well completed

firm name

county well located

LANDOWNER:	description of formations encountered	from	to
Steve FRATEZI			
LeLard, (mailing address)	CLAY	0	30
	SANDY CLAY	30	45
	SAND + PEAT GRAVEL	45	70
	SAND + GRAVEL	70	95
WELL LOCATION:			
sec. <u>36</u> T. <u>19</u> N R. <u>7</u> E & W			
<u>3 1/2</u> miles <u>N</u> of <u>Elizabeth</u> (distance) (direction) (nearest town)			
WELL PURPOSE: <u>IRR</u> (home, irrigation, municipal, industrial)			
WELL COMPLETION DATA:			
(1) diameter (inches) <u>16</u>			
(2) total depth (feet) <u>95</u>			
(3) static water level (feet) <u>15</u> below above top of ground.			
(4) casing <u>Steel</u> , <u>55</u> (material) (depth) <u>16</u> (size) if telescope see back.			
(5) screen <u>40</u> , <u>55</u> (length) (depth to top)			
<u>16</u> <u>Steel</u> (size) (material)			
(6) pump <u>50</u> <u>2500</u> (HP) (yield gpm) <u>Diesel</u> (type power)			
(7) electric log <u>No</u> (yes or no)			
(organization running log)			
(8) how well bottom plugged <u>Steel Plate</u>			
DRILLERS REMARKS:			


RECEIVED

MAY 4 - 1977

MISS. BD. OF WATER COMMISSIONERS

If well telescopes please sketch and show depths.

GROUND LEVEL

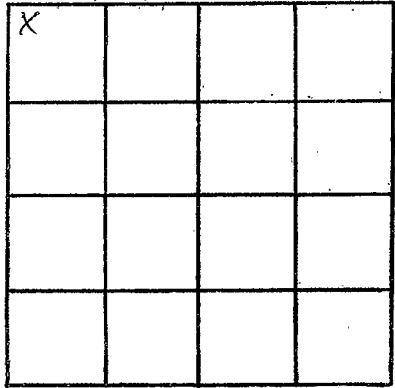

SECTION 36

Please indicate well location X.

ADDITIONAL INFORMATION

If more than one screen, show locations of each on sketch.