

Washington
B1005

MISSISSIPPI
BOARD OF WATER COMMISSIONERS
416 North State Street
Jackson, Mississippi 39201

WATER WELL DRILLERS LOG

8/28/78

28 Aug
date well completed

1978 Lambert
firm name

Wash
county well located

LANDOWNER:	description of formations encountered	from	to
<u>Fred Brown</u>			
<u>Greenville, Miss.</u> (mailing address)	<u>Mixed</u>	<u>0</u>	<u>15</u>
WELL LOCATION:	<u>Sand</u>	<u>15</u>	<u>60</u>
sec. <u>6</u> T. <u>19</u> N. R. <u>7</u> E	<u>Sand & gravel</u>	<u>60</u>	<u>80</u>
<u>10</u> miles <u>NE</u> of <u>Greenville</u>	<u>rock</u>	<u>80</u>	<u>82</u>
(distance) (direction) (nearest town)	<u>gravel</u>	<u>82</u>	<u>130</u>
WELL PURPOSE: <u>home</u> (home, irrigation, municipal, industrial)	<u>Clay</u>	<u>130</u>	<u>165</u>
WELL COMPLETION DATA:	<u>Clay st sand</u>	<u>165</u>	<u>270</u>
(1) diameter (inches) <u>4x2</u>	<u>rock</u>	<u>270</u>	<u>271</u>
(2) total depth (feet) <u>470-465</u>	<u>Clay st sand</u>	<u>271</u>	<u>405</u>
(3) static water level (feet) <u>38</u> below top of ground.	<u>Sand gravel</u>	<u>405</u>	<u>470</u>
(4) casing <u>PVC</u> (material) (depth)			
<u>4x2</u> if telescope see back. (size)			
(5) screen <u>20</u> (length) (depth to top)			
(size) (material)			
(6) pump <u>1</u> <u>20</u> (HP) (yield gpm)			
<u>elect</u> (type power)			
(7) electric log <u>no.</u> (yes or no)			
(organization running log)			
(8) how well bottom plugged <u>back process</u>			
DRILLERS REMARKS:			

Miss. Board of Water Comm.

APR 4 1979

RECEIVED

If well telescopes please
sketch and show depths.

GROUND LEVEL

4"

140


2"

445

445

2" ss.

465

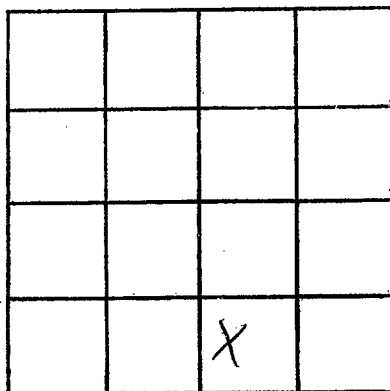

SECTION 6

Please indicate well location X.

ADDITIONAL INFORMATION

If more than one screen,
show locations of each on sketch.