

WASHINGTON

B 1009

11-6-78

MISSISSIPPI
BOARD OF WATER COMMISSIONERS
416 North State Street
Jackson, Mississippi 39201

WATER WELL DRILLERS LOG

11-6
date well completed

1978 Barley Drilling Co.
firm name

Washington
county well located

LANDOWNER: Percy Baronet

Leland, Miss.

(mailing address)

WELL LOCATION:

sec. 11 T. 19 N. R. 7 E
S W
6 miles N of Leland
(distance) (direction) (nearest town)

WELL PURPOSE: Home
(home, irrigation, municipal, industrial)

WELL COMPLETION DATA:

- (1) diameter (inches) 4 X 2
- (2) total depth (feet) 500
- (3) static water level (feet) 19 below
top of ground.
- (4) casing Steel, 480,
(material) (depth)
4 X 2 if telescope see back.
(size)
- (5) screen 20, 480
(length) (depth to top)
2", Stainless Steel
(size) (material)
- (6) pump 1, 18
(HP) (yield gpm)
Electric
(type power)
- (7) electric log No
(yes or no)

(organization running log)

(8) how well bottom plugged
back pressure valve

DRILLERS REMARKS:

description of formations encountered

from to

Clay	0	19
Sand	19	85
Gravel	85	160
Mud	160	235
Mud Sand	235	270
Sand		
Mud	160	210
Sand	210	235
Mud	235	270
Sand	370	500


RECEIVED

NOV - 9 1978

MISS. BD. OF WATER COMM

If well telescopes please sketch and show depths.

GROUND LEVEL

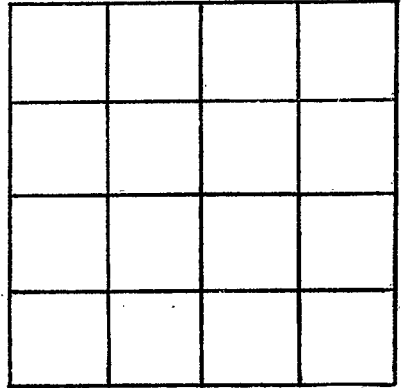

SECTION _____

Please indicate well location X.

ADDITIONAL INFORMATION

If more than one screen,
show locations of each on sketch.