

WASHINGTON

~~Bolivar~~

B1007

MISSISSIPPI  
BOARD OF WATER COMMISSIONERS  
416 North State Street  
Jackson, Mississippi 39201

WATER WELL DRILLERS LOG

WASHINGTON

9-11-79

9-11

1979 Larry's Well Pumps Co

Bolivar

date well completed

firm name

county well located

LANDOWNER: R C Minton  
Benoit Miss

description of formations encountered

from

to

(mailing address)

WELL LOCATION:

sec. 10 T 19 N

R

E

4 1/2 W

miles

2 S

of

Choctaw

(distance)

(direction)

(nearest town)

clay	0	20
med sand	20	55
coarse sand	55	70
coarse sand & gra.	70	99
clay	99	380
fine sand	380	400
clay sand	400	475
coarse sand	475	500

WELL PURPOSE:

(home, irrigation, municipal, industrial)

WELL COMPLETION DATA:


- (1) diameter (inches) 2"
- (2) total depth (feet) 500'
- (3) static water level (feet) 20' below above top of ground.
- (4) casing plastic 480' (material) (depth)
- (size) If telescope see back.
- (5) screen 20' 480' (length) (depth to top)
- 2" plastic (size) (material)
- (6) pump 1/2 10 (HP) (yield gpm)
- Electric (type power)
- (7) electric log (yes or no)
- (organization running log)
- (8) how well bottom plugged wash valve

REC'D 9-15-79

DRILLERS REMARKS:

If well telescopes please sketch and show depths.

GROUND LEVEL

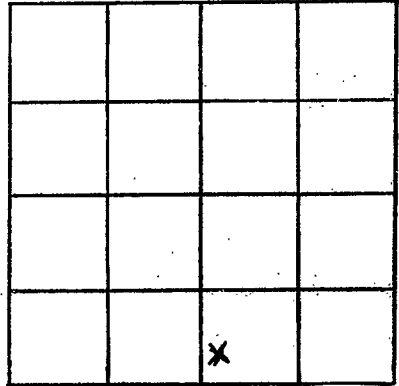

SECTION 10

Please indicate well location X.

ADDITIONAL INFORMATION

If more than one screen, show locations of each on sketch.