

Wash.
 B 1008
 9-12-79

MISSISSIPPI
 BOARD OF WATER COMMISSIONERS
 416 North State Street
 Jackson, Mississippi 39201

WATER WELL DRILLERS LOG

12 Sept 1979 Lambert Drilling Co. Wash.
 date well completed firm name county well located

LANDOWNER:	description of formations encountered	from	to
Billy Johnson			
Greenville MISS. (mailing address)	Clay	0	25
WELL LOCATION: sec. 4 T 19 N R 7 E W 8	Sand	25	60
12 miles NE of Greenville (distance) (direction) (nearest town)	Sand & gravel	60	115
WELL PURPOSE: home (home, irrigation, municipal, industrial)	Clay blue	115	195
WELL COMPLETION DATA:	Clay & Sand	195	315
(1) diameter (inches) 4 1/2	Rock	315	316
(2) total depth (feet) 420	Sand	316	325
(3) static water level (feet) 31 below above top of ground.	Rock	325	326
(4) casing PVC, 406, (material) (depth) 4 1/2 (size) if telescope see back.	Sand fine	326	360
(5) screen 20, 420-400 (length) (depth to top) 2" (size) PVC (material)	Sand med	360	390
(6) pump 1, 20 (HP) (yield gpm) elect (type power)	Sand good	390	420
(7) electric log (yes or no)			
(organization running log)			
(8) how well bottom plugged: back press.			

DEPT. OF NATURAL RESOURCES
 BUREAU OF LAND & WATER RESOURCES

JAN 9 1980

RECEIVED

DRILLERS REMARKS:


If well telescopes please sketch and show depths.

GROUND LEVEL

4' 400

2' 400

50' 2' 420

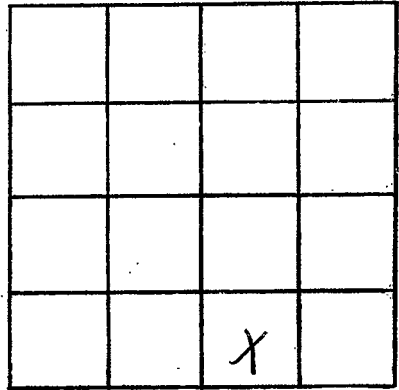

SECTION 4

Please indicate well location X.

ADDITIONAL INFORMATION

If more than one screen, show locations of each on sketch.