

MISSISSIPPI DEPARTMENT OF NATURAL RESOURCES

Bureau of Land and Water Resources

Southport Mall

P.O. Box 10631

Jackson, Mississippi 39209

WATER WELL DRILLERS LOG

Washington
B1009

16 Dec 1981 date well completed Lambert Drilling firm name Wash county well located

LANDOWNER:	description of formations encountered	from	to
Ralf Owens Greenville, Miss. (mailing address)			
WELL LOCATION:	Clay	15	30
sec. 29 T 19 N R 7 E 8 miles NE of Greenville (distance) (direction) (nearest town)	Sand	30	80
WELL PURPOSE:	Fine gravel	80	100
(home, irrigation, municipal, industrial)	Clay	100	220
WELL COMPLETION DATA:	Clay st Sand	220	380
(1) diameter (inches) 4x3	Sand Fine	380	460
(2) total depth (feet) 510	Sand good	460	510
(3) static water level (feet) 56 below above top of ground.			
(4) casing PVC 490 (material) (depth) 4x3 (size) if telescope see back.			
(5) screen 20 510-490 (length) (depth to top) 3 PVC (size) (material)			
(6) pump 1/2 26 (HP) (yield gpm) elect (type power)			
(7) electric log no (yes or no) (organization running log)			
(8) how well bottom plugged back plug			
DRILLERS REMARKS:			

DEPT. OF NATURAL RESOURCES
BUREAU OF LAND & WATER RESOURCES

FEB - 9 1982

RECEIVED


If well telescopes please sketch and show depths.

GROUND LEVEL

180 4"

3' 490

20 ft sec. 510

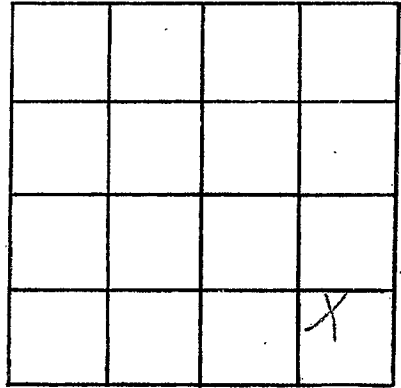

SECTION 29

Please indicate well location X.

ADDITIONAL INFORMATION

If more than one screen,
show locations of each on sketch.