

MISSISSIPPI DEPARTMENT OF NATURAL RESOURCES

Bureau of Land and Water Resources

Southport Mall

P.O. Box 10631

Jackson, Mississippi 39209

WATER WELL DRILLERS LOG

Washington  
B1011

6-19 1984 Schultz Drilling Washington  
date well completed firm name county well located

<p>LANDOWNER: Mack Gowerz Leland MS</p>	<p>description of formations encountered</p>	<p>from</p>	<p>to</p>
<p>(mailing address)</p>	<p>CLAY SAND</p>	<p>0</p>	<p>20</p>
<p>WELL LOCATION: sec. 4 T 19 N R 7 E 3 miles N of Leland (distance) (direction) (nearest town)</p>	<p>SAND + pea gravel SAND + gravel CLAY FINE SAND SAND + CLAY streaks SAND</p>	<p>20</p>	<p>60</p>
<p>WELL PURPOSE: Home (home, irrigation, municipal, industrial)</p>	<p>60</p>	<p>120</p>	<p>120</p>
<p>WELL COMPLETION DATA:</p>	<p>120</p>	<p>170</p>	<p>170</p>
<p>(1) diameter (inches) 4" x 2"</p>	<p>170</p>	<p>340</p>	<p>340</p>
<p>(2) total depth (feet) 470'</p>	<p>340</p>	<p>380</p>	<p>380</p>
<p>(3) static water level (feet) 22' below top of ground.</p>	<p>380</p>	<p>410</p>	<p>410</p>
<p>(4) casing PUC 450' (material) (depth)</p>	<p>410</p>	<p>470</p>	<p>470</p>
<p>(5) screen 20' 450' (length) (depth to top) 2" PUC (size) (material)</p>	<p>470</p>	<p></p>	<p></p>
<p>(6) pump 1 20 (HP) (yield gpm) ele (type power)</p>	<p></p>	<p></p>	<p></p>
<p>(7) electric log no (yes or no) (organization running log)</p>	<p></p>	<p></p>	<p></p>
<p>(8) how well bottom plugged b/w</p>	<p></p>	<p></p>	<p></p>

DRILLERS REMARKS: y


DEPT. OF NATURAL RESOURCES  
BUREAU OF LAND & WATER RESOURCES

JUN 25 1984

RECEIVED

If well telescopes please sketch and show depths.

GROUND LEVEL

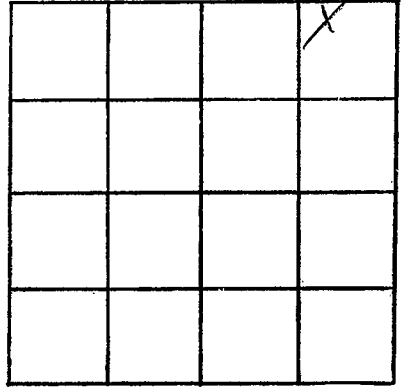

SECTION 2

Please indicate well location X.

ADDITIONAL INFORMATION

If more than one screen,  
show locations of each on sketch.