

WASHINGTON
B 2000

MISSISSIPPI DEPARTMENT OF NATURAL RESOURCES
Bureau of Land and Water Resources
Southport Mall
P.O. Box 10631
Jackson, Mississippi 39209
WATER WELL DRILLERS LOG

8-11-87, Schultz Drilling Washington
date well completed firm name county well located

LANDOWNER: Clint Johnson
Hwy 61 N
Leland, MS
(mailing address)

description of formations encountered	from	to
CLAY	0	10
SAND	10	80

WELL LOCATION:
sec. 30 T. 19 N R. 7 E
2 miles N of Leland
(distance) (direction) (nearest town)

WELL PURPOSE: HOME
(home, irrigation, municipal, industrial)

- WELL COMPLETION DATA:
- (1) diameter (inches) 2"
 - (2) total depth (feet) 80'
 - (3) static water level (feet) 29' below top of ground.
 - (4) casing PVC, 70' (material) (depth)
 - (size) if telescope see back.
 - (5) screen 10' 70' (length) (depth to top)
 - 2" PVC (size) (material)
 - (6) pump 1 (HP) 10 (yield gpm)
 - ele (type power)
 - (7) electric log NO (yes or no)
 - X (organization running log)
 - (8) how well bottom plugged CAP


RECEIVED
OCT 15 1987

Department of Natural Resources
Bureau of Land & Water Resources

DRILLERS REMARKS:

If well telescopes please sketch and show depths.

GROUND LEVEL

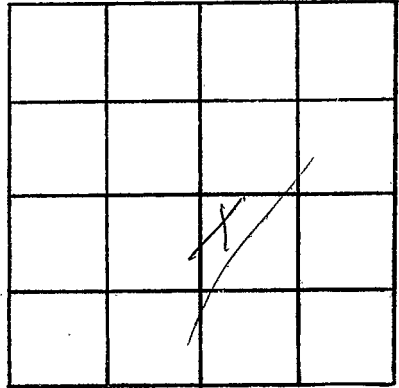

SECTION 30

Please indicate well location X.

ADDITIONAL INFORMATION

If more than one screen, show locations of each on sketch.