

Washington
 C10
 2-68

MISSISSIPPI
 BOARD OF WATER COMMISSIONERS
 416 North State Street
 Jackson, Mississippi 39201

WATER WELL DRILLERS LOG

FEB 20 1968 DYER WELL DRILLER WABIA
 date well completed firm name county well located

LANDOWNER: HARRISON RANKIN

description of formations encountered

from to

1082 BASKIN DR.

CLAY

0 13

GREENVILLE, MISS.

FINE SAND

13 33

(mailing address)

MED. SAND

33 63

MED. SAND & GRAVEL

63 103

WELL LOCATION:

sec. 7 T. 19 N. R. 6 E
6 miles NO. of ELIZA BETH.
 (distance) (direction) (nearest town)

WELL PURPOSE: IRRIGATION
 (home, irrigation, municipal, industrial)

WELL COMPLETION DATA:

- (1) diameter (inches) 16"
 (2) total depth (feet) 103'
 (3) static water level (feet) 15' below above top of ground.
 (4) casing IRON 63'
 (material) (depth)

if telescope see back.
 (size)

- (5) screen 42' 63'
 (length) (depth to top)

16" BRIC INGOT
 (size) (material)

- (6) pump 60 3,000
 (HP) (yield gpm)


Dieser
 (type power)

- (7) electric log NO
 (yes or no)

(organization running log)


- (8) how well bottom plugged PLATE ON BOTTOM

DRILLERS REMARKS:

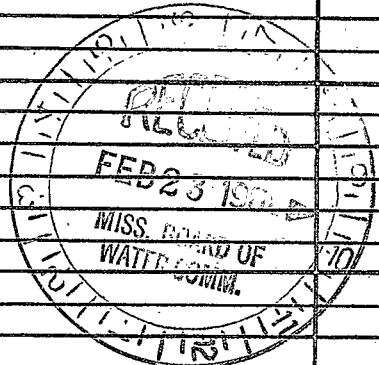

If well telescopes please sketch and show depths.

GROUND LEVEL

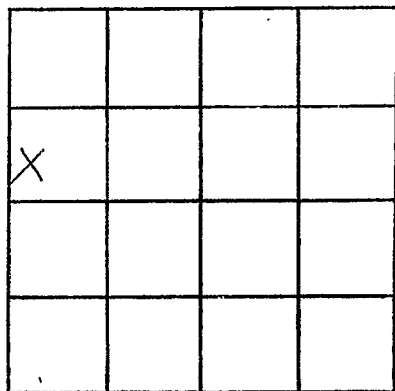

SECTION 7

Please indicate well location X.

ADDITIONAL INFORMATION

If more than one screen, show locations of each on sketch.