


Washington
 C 12
 12-66

MISSISSIPPI
 BOARD OF WATER COMMISSIONERS
 416 North State Street
 Jackson, Mississippi 39201

WATER WELL DRILLERS LOG

12-14-66 19 Butane Gas Co. of Wood WASHINGTON
 date well completed firm name county well located

LANDOWNER:	description of formations encountered	from	to
VERNON SKELTON			
Rt. 2 Leland (mailing address)	CLAY	0	10
	SAND	10	40
	GRAVEL	40	190
WELL LOCATION: sec. 31 T 19 N R 6 E 3 miles N of Leland (distance) (direction) (nearest town)	CLAY + shale	190	370
	SAND	370	461
WELL PURPOSE: Home (home, irrigation, municipal, industrial)			
WELL COMPLETION DATA: (1) diameter (inches) 4 3/4 (2) total depth (feet) 461 (3) static water level (feet) 19' below top of ground. (4) casing Steel, 440 (material), (depth) 3" x 2" (size) if telescope see back. (5) screen 20 (length), 440 (depth to top) 2" (size), STAINLESS STEEL (material) (6) pump 1 (HP), 10 (yield gpm) Elec. (type power) (7) electric log NO (yes or no) (organization running log) (8) how well bottom plugged BRASS BACK WASH VALVE			
DRILLERS REMARKS:			

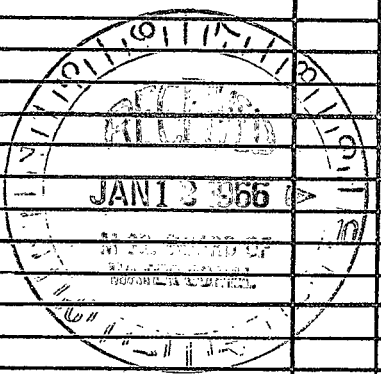

If well telescopes please sketch and show depths.

GROUND LEVEL

84'
3" CASING

376'
3" CASING

20'
2" SCREEN

		X	

SECTION 31

Please indicate well location X.

ADDITIONAL INFORMATION

If more than one screen, show locations of each on sketch.