

Washington
 C14
 1-68

MISSISSIPPI
 BOARD OF WATER COMMISSIONERS
 416 North State Street
 Jackson, Mississippi 39201

WATER WELL DRILLERS LOG

Date well completed 19 68 Feb 22 firm name Opeliter Drilling county well located Washington
0193

LANDOWNER: Brown Plantings
Maurice Brown

description of formations encountered

from to

Leland Miss
 (mailing address)

Clay 0 9
Sand 9 140

WELL LOCATION:

sec. 30 T. 19 N R. 6 E
S W
5 miles N of Leland
 (distance) (direction) (nearest town)

Clay 140 210
Shale 210 240

WELL PURPOSE:


(home, irrigation, municipal, industrial) Home

Clay 240 260

WELL COMPLETION DATA:

- (1) diameter (inches) 4 1/2"
- (2) total depth (feet) 473
- (3) static water level (feet) 22 below top of ground
- (4) casing Galv 453
 (material) (depth)
- 4 1/2" (size) if telescope see back.
- (5) screen 20 (length) (depth to top)
2" (size) Stainless (material)
- (6) pump 1 (HP) 20+ (yield gpm)
Elec (type power)
- (7) electric log No (yes or no)
- (organization running log) _____
- (8) how well bottom plugged Pin

Sand Fine 260 350
Clay 350 410
SAND Good 410 483

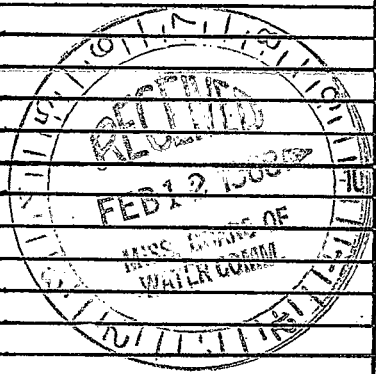

DRILLERS REMARKS:

and is good
fine to med

