

PETE

Washington
C15
2-68

MISSISSIPPI
BOARD OF WATER COMMISSIONERS
416 North State Street
Jackson, Mississippi 39201

WATER WELL DRILLERS LOG

FEB. 17 1968

19

DYER WELL & IRR.
608 HARRIS

WASH.

date well completed

firm name

county well located

LANDOWNER: HARRISON RANCH

1082 BASCOM DR.

GREENVILLE, MISS.

(mailing address)

description of formations encountered

from

to

CLAY

0 12

FINE SAND

12 33

MED. SAND

33 43

COARSE SAND

43 53

FINE SAND

53 63

COARSE SAND & GRAVEL

63 93

MED. SAND

93 103

WELL LOCATION:

sec. 7 T. 19 N R. 6 E
6 miles N 10 of ELIZABETH
(distance) (direction) (nearest town)

WELL PURPOSE:

(home, irrigation, municipal, industrial)

WELL COMPLETION DATA:

(1) diameter (inches) 14"

(2) total depth (feet) 124

(3) static water level (feet) 14 below top of ground

(4) casing (material) IRON (depth) 64'

(size) if telescope see back.

(5) screen (length) 40' (depth to top) 64'

16" BLK. INBOT (size) (material)

(6) pump 50 2500 (HP) (yield gpm)


DIESEL (type power)

(7) electric log No (yes or no)

(organization running log)


(8) how well bottom plugged PLATE ON BOTTOM

DRILLERS REMARKS:

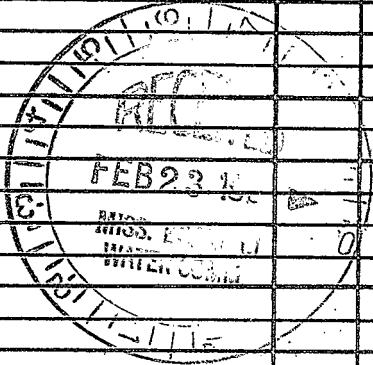

If well telescopes please sketch and show depths.

GROUND LEVEL

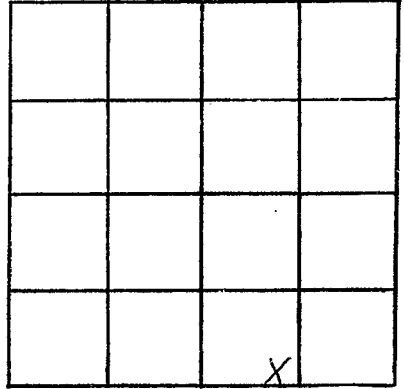

SECTION 7

Please indicate well location X.

ADDITIONAL INFORMATION

If more than one screen, show locations of each on sketch.