

WASH. ~~3-18-64~~ C16
3-18-64

WATER WELL DRILLERS LOG

Date: 3/18, 1964, Driller: Bailey Drlg. Co. County, Washington
(Name)

(1) Owner of Land: John Collier
(Name)
Leland, Miss.
(Address)

(2) Location: 1/4, 1/4, Sec. 33 ^{Diameter 1/2} T R
6 miles N.E., of Leland
(distance) (direction) (Nearest Town)

(3) Topography: Flat
(Hilly) (Flat) (Level)

(4) Purpose of Well: Domestic
(Domestic Irrigation
Municipal, Industrial, Other)

Description & Color of Materials Sand, Clay, Red Clay, Shell, etc.	Thick- ness Feet	Depth Feet
Clay		18
Sand		60
Gravel		150
Mud		410
Sand + Mud		460
Sand		480
Sand + Mud		520
Sand		600
Sand + Mud		640
Sand		660
mud		695
Sand		710
mud		900
Sand		990

Information upon completion of well:

(1) Diameter 4x2 1/2 inches.


(2) Total Depth 990 feet.

(3) Water Level 20 feet below top of ground.

(4) Cased to all way, Size 4x2 1/2

(5) Screen: Size 2 1/2, Length 30ft.

(6) Were any formations sealed against pollution?
no

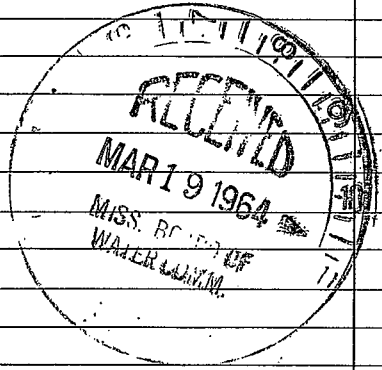

If YES depth of formation _____
Why _____
Drillers Remarks: _____

Well No.

(Use Back Side)

