

Washington
 C 19
 8-6-67

MISSISSIPPI
 BOARD OF WATER COMMISSIONERS
 416 North State Street
 Jackson, Mississippi 39201
 WATER WELL DRILLERS LOG

8/17/67
 C 25 **EXEMPTED**

August 6, 19 67 Layne-Central Company Washington
 date well completed firm name county well located

LANDOWNER: W. H. Burns

description of formations encountered	from	to
Clay	0	12
Fine sand	12	27
Coarse sand	27	37
Coarse sand, pea gravel	37	67
Coarse sand, gravel	67	108

Leland, Mississippi
 (mailing address)


WELL LOCATION:
 sec. 10 T 19 N R 6 E
 S W
 3 miles east of Helm
 (distance) (direction) (nearest town)

WELL PURPOSE: irrigation
 (home, irrigation, municipal, industrial)

WELL COMPLETION DATA:


- (1) diameter (inches) 16
- (2) total depth (feet) 108
- (3) static water level (feet) 17' ~~below~~ above top of ground.
- (4) casing steel, 58' (material), (depth),
 16" (size) if telescope see back.
- (5) screen 50' (length), 108' (depth to top)
 16" (size), Armco (material)
- (6) pump 70 (HP), 2100 (yield gpm)
 engine (type power)
- (7) electric log no (yes or no)
 (organization running log)
- (8) how well bottom plugged plate

DRILLERS REMARKS:

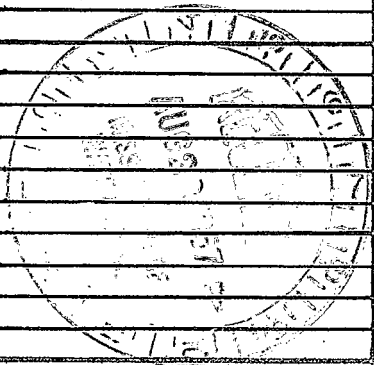

If well telescopes please sketch and show depths.

GROUND LEVEL

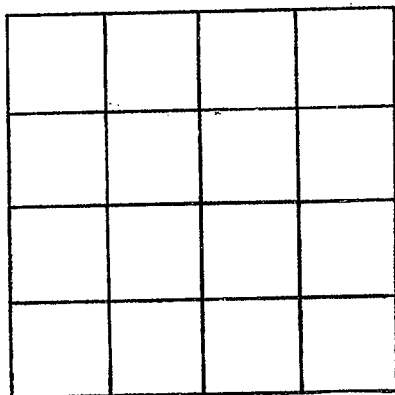

SECTION _____

Please indicate well location X.

ADDITIONAL INFORMATION

If more than one screen, show locations of each on sketch.