

CODED  
C 2509

10/6/67  
JW

MISSISSIPPI  
BOARD OF WATER COMMISSIONERS  
416 North State Street  
Jackson, Mississippi 39201

WATER WELL DRILLERS LOG

September 5, 1967 Layne-Central Company Washington  
date well completed firm name county well located

LANDOWNER: W. H. Burns

description of formations encountered

from to

Leland, Mississippi  
(mailing address)

Clay	0	16
Coarse sand	16	45
Coarse sand, pea gravel	45	75
Coarse sand, gravel	75	144
Blue clay	144	157
White sand	157	167
Lime stone	167	171
Sandy shale	171	281
Sand with strks. shale	281	310
White sand	310	692
Sand & shale	692	727
Shale	727	740
Clay	740	800
Rock	800	801
Shale	801	867
Rock	867	868
Shale, sandy	868	874
Sand	874	937
Sahle	937	940

WELL LOCATION:


sec 10 T. 19 N. 6 R. E  
S W  
2 miles east of Helm  
(distance) (direction) (nearest town)

WELL PURPOSE: home  
(home, irrigation, municipal, industrial)

WELL COMPLETION DATA:


- (1) diameter (inches) 4x3
- (2) total depth (feet) 940' 9"
- (3) static water level (feet) 191' 2" below top of ground. 796' of 3"
- (4) casing steel, 105' 3" of 4"  
(material) (depth)
- 4" 2x3" if telescope see back.  
(size)
- (5) screen 31' 11" , 932' 4"  
(length) (depth to top)
- 3" Stainless Steel  
(size) (material)
- (6) pump 1 30  
(HP) (yield gpm)
- electric  
(type power)
- (7) electric log no  
(yes or no)
- (organization running log)
- (8) how well bottom plugged shot

DRILLERS REMARKS:

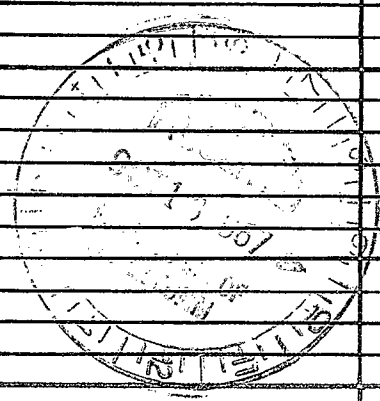

If well telescopes please sketch and show depths.

GROUND LEVEL

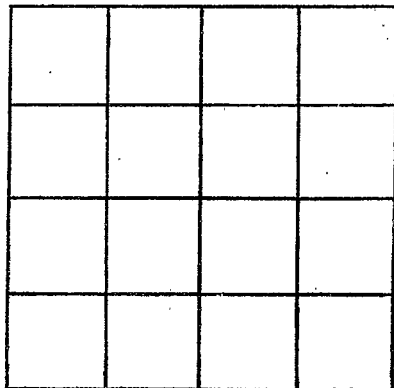

SECTION 10

Please indicate well location X.

ADDITIONAL INFORMATION

If more than one screen,  
show locations of each on sketch.