

Total 11

12506

CODED
9/11/69
Jm

MISSISSIPPI
BOARD OF WATER COMMISSIONERS
416 North State Street
Jackson, Mississippi 39201

WATER WELL DRILLERS LOG

C2887

Washington
C.M.
5-15-69

May 15, 1969 Layne-Central Company Washington
date well completed firm name county well located


LANDOWNER: Ray F. Beckham	description of formations encountered	from	to
	Clay	0	19
	Sand	19	35
Leland, Mississippi (mailing address)	Coarse sand, pea gravel	35	75
	Coarse sand, pea gravel and gravel	75	110
	Boulders		110
WELL LOCATION: sec. 10 T. 19 N R. 6 Ex. W 1 miles E of Helm (distance) (direction) (nearest town)			
WELL PURPOSE: irrigation (home, irrigation, municipal, industrial)			
WELL COMPLETION DATA:			
(1) diameter (inches) 16			
(2) total depth (feet) 110			
(3) static water level (feet) 16' xxxx above top of ground.			
(4) casing steel, 60' (material) (depth) 16" if telescope see back. (size)			
(5) screen 50', 110' (length) (depth to top) 16", Armco (size) (material)			
(6) pump 70, 2000 (HP) (yield gpm) engine (type power)			
(7) electric log no (yes or no) (organization running log)			
(8) how well bottom plugged plate			

DRILLERS REMARKS:

SEP 18 1969
MISS. Bd. OF
WATER COMM.

If well telescopes please
sketch and show depths.

GROUND LEVEL

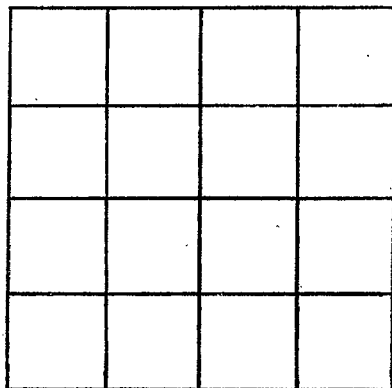

SECTION _____

Please indicate well location X.

ADDITIONAL INFORMATION

If more than one screen,
show locations of each on sketch.