

WASHINGTON
C 22
9-14-67

MISSISSIPPI
BOARD OF WATER COMMISSIONERS
416 North State Street
Jackson, Mississippi 39201

CODED

WATER WELL DRILLERS LOG

9-14-67 19 ARCO Drilling Inc. date well completed firm name county well located

LANDOWNER:
Charles E Fratesy
RT-2 - Box 220
Leland Miss -
(mailing address)

description of formations encountered	from	to
Blue + Brown clay	0	19
Blue clay	19	30
Soft Blue clay	30	38
Fine sand	38	59
Medium sand + medium gravel	59	67
Fine to medium sand	67	78
Course sand - med. gravel	78	96
Blue clay	96	98
Fine to coarse sand med. gravel	98	103
Fine to coarse gravel	103	114

WELL LOCATION:
sec. 31 T. 19 N. R. 6 E
S (W)
_____ miles of Greenville
(distance) (direction) (nearest town)

WELL PURPOSE: irrigation
(home, irrigation, municipal, industrial)

WELL COMPLETION DATA:

(1) diameter (inches) 10"

(2) total depth (feet) 118' 6"

(3) static water level (feet) 13 below top of ground.

(4) casing Steel, 36.6" (material) (depth)
No (size) if telescope see back.


(5) screen 32" (length), 36.6" (depth to top)
10" (size), Steel (material)

(6) pump 30 (HP), 1300 G.P.M. (yield gpm)
Electric (type power)

(7) electric log NO (yes or no)
(organization running log)


(8) how well bottom plugged Steel
Grate

CODED

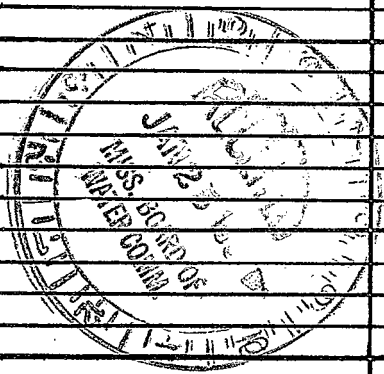

DRILLERS REMARKS: none

If well telescopes please sketch and show depths.

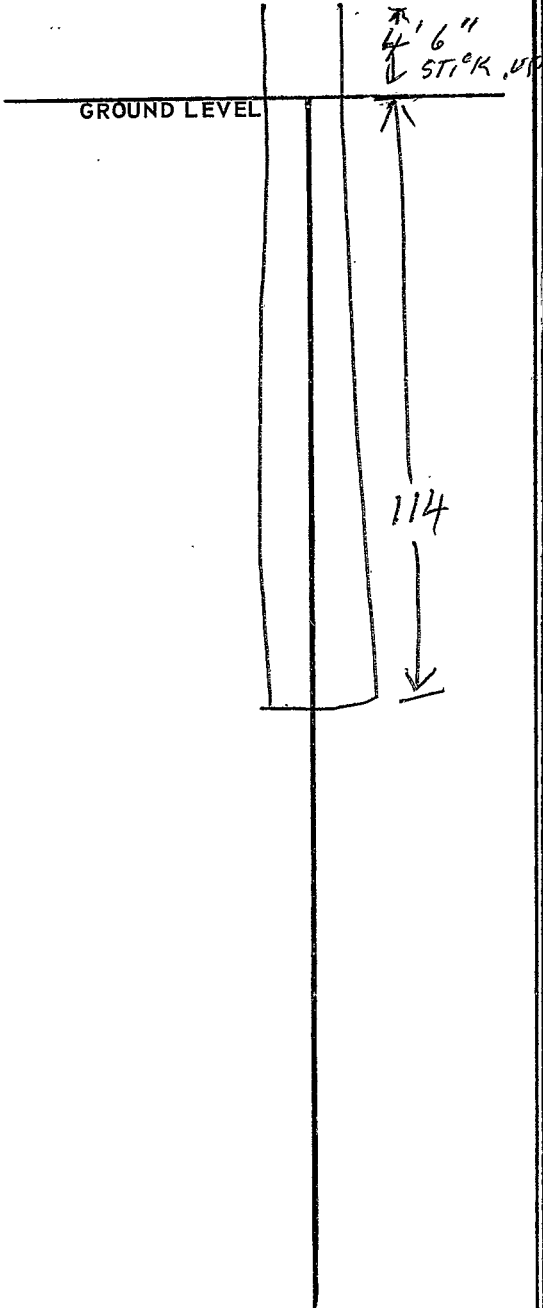

SECTION _____

Please indicate well location X.

ADDITIONAL INFORMATION

*Well was left
4 1/2 ft in air to
have the bucket cover
it.*

If more than one screen, show locations of each on sketch.