

WASHINGTON  
C23  
4-20-71

MISSISSIPPI  
BOARD OF WATER COMMISSIONERS  
416 North State Street  
Jackson, Mississippi 39201

**CODED**

WATER WELL DRILLERS LOG

DYER WELL & IRRIGATION SERVICE WASHINGTON

4/20/71 19  
date well completed

firm name

county well located

LANDOWNER:

CAREY PRATHER

description of formations  
encountered

from

to

LELAND, MISS  
(mailing address)

CLAY	0	22
FINE SAND	22	33
COARSE SAND	33	38
FINE SAND	38	46
SAND & COBBLER	46	107

WELL LOCATION:

sec. 19 T 19 N R 6 E  
3 miles N of ELIZABETH  
(distance) (direction) (nearest town)

WELL PURPOSE:

FRP.  
(home, irrigation, municipal, industrial)

WELL COMPLETION DATA:

- diameter (inches) 16"
- total depth (feet) 107'
- static water level (feet) 18' below top of ground.
- casing Blx In 67' (material) (depth)  
16" (size) if telescope see back.
- screen 40' 67' (length) (depth to top)  
16" Blx In bot (size) (material)
- pump 60 3000 (HP) (yield gpm)  
DIESEL (type power)
- electric log 1/0 (yes or no)

**CODED**

(organization running log)

(8) how well bottom plugged PLATE


MAY 3 - 1971

MISS. BD. OF  
WATER COMM.

DRILLERS REMARKS:

If well telescopes please sketch and show depths.

GROUND LEVEL

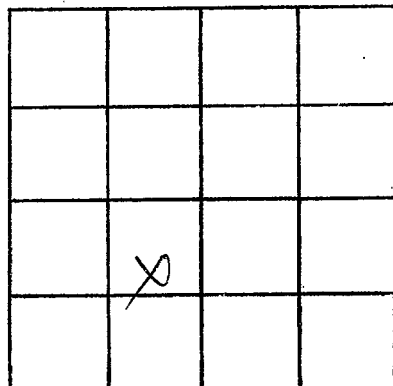

SECTION 19

Please indicate well location X.

ADDITIONAL INFORMATION

If more than one screen,  
show locations of each on sketch.