

WASHINGTON
C-25
6-21-71

MISSISSIPPI
BOARD OF WATER COMMISSIONERS
416 North State Street
Jackson, Mississippi 39201

CODED

WATER WELL DRILLERS LOG

6/21 1971 date well completed
E. W. Plumbing firm name
Wash. county well located

LANDOWNER: Wash. County
School Wash. County
Court House
(mailing address)

description of formations encountered	from	to
clay type	0	15
Sand	15	47

WELL LOCATION:
sec. 16 T. 19 N. R. 6 E.
1 S. miles E. of
(distance) (direction) (nearest town)

WELL PURPOSE: Home
(home, irrigation, municipal, industrial)

- WELL COMPLETION DATA:
- (1) diameter (inches) 2
 - (2) total depth (feet) 47
 - (3) static water level (feet) 15 below top of ground.
 - (4) casing Galv. 42 (material) (depth)
 - (size) if telescope see back.
 - (5) screen 5 42 (length) (depth to top)
 - 2 Galv. (size) (material)
 - (6) pump 100 gpm (HP) (yield gpm)
 - Hand (type power)
 - (7) electric log (yes or no)

CODED

JUL 23 1971

MISS. BD. OF WATER COMMISSIONERS


(organization running log)
Shell Point
(8) how well bottom plugged

DRILLERS REMARKS:

47

If well telescopes please sketch and show depths.

GROUND LEVEL

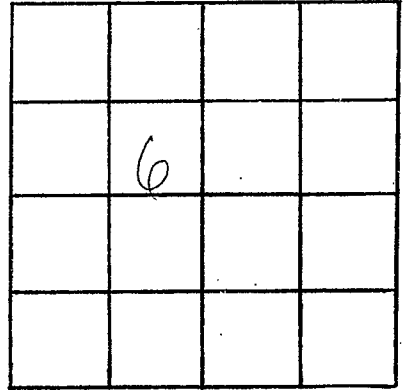

SECTION _____

Please indicate well location X.

ADDITIONAL INFORMATION

If more than one screen,
show locations of each on sketch.