

WASHINGTON
C 27
12-17-71

MISSISSIPPI
BOARD OF WATER COMMISSIONERS
416 North State Street
Jackson, Mississippi 39201 FEB 14 1972

WATER WELL DRILLERS LOG

12-17-71 date well completed
Schultz Drilling firm name
Washington county well located

LANDOWNER: <u>Bob. Dennis</u>	description of formations encountered	to
<u>Selena Mims</u> (mailing address)	Clay Sand	0 12 12 128
WELL LOCATION: sec. <u>30</u> T. <u>19</u> N R. <u>6</u> E (distance) miles (direction) of (nearest town)	Clay sandy shale	128 210 210 247
WELL PURPOSE: (home, irrigation, municipal, industrial)	Clay	247 270
WELL COMPLETION DATA:	Sand Fine	270 346
(1) diameter (inches) <u>4 X 2</u>	Clay	346 406
(2) total depth (feet) <u>472</u>	Sand	406 480
(3) static water level (feet) <u>24</u> (below/above top of ground)		
(4) casing <u>Galv</u> (material) (depth) <u>406</u> if telescope see back. (size)		
(5) screen <u>20</u> (length) (depth to top) <u>2"</u> (size) <u>STAINLESS</u> (material)		
(6) pump <u>1</u> (HP) <u>25</u> (yield gpm) <u>ele</u> (type power)		
(7) electric log <u>no</u> (yes or no)		
(organization running log)		
(8) how well bottom plugged <u>Partial</u>		
DRILLERS REMARKS:		

CODED

CODED


If well telescopes please sketch and show depths.

GROUND LEVEL

105 ft
4'

94 ft
2'

40 ft
Screen

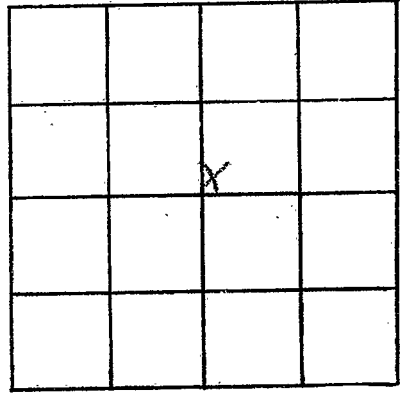

SECTION 30

Please indicate well location X.

ADDITIONAL INFORMATION

If more than one screen, show locations of each on sketch.