

C 29
 WASHINGTON
 4-18-73

MISSISSIPPI
 BOARD OF WATER COMMISSIONERS
 416 North State Street
 Jackson, Mississippi 39201

WATER WELL DRILLERS LOG

CODED

4/18 1973 date well completed
 J. S. Smith, Dr. Hays, Washington firm name
 county well located

LANDOWNER: Alex P. Smith	description of formations encountered	from	to
Poland Miss (mailing address)			
	Sand	14	65

WELL LOCATION:
 sec. 31 T. 19 N R. 6 E
 3 miles N of Poland
 (distance) (direction) (nearest town)

CODED


WELL PURPOSE: Home
 (home, irrigation, municipal, industrial)

- WELL COMPLETION DATA:
- (1) diameter (inches) 2"
 - (2) total depth (feet) 65
 - (3) static water level (feet) 17 below top of ground.
 - (4) casing P.V.C. (material), (depth), (size) If telescope see back.
 - (5) screen 5 (length), (depth to top) 2' (size), P.V.C. (material)
 - (6) pump 1 (HP), 12 (yield gpm) Fluor (type power)
 - (7) electric log Yes (yes or no)
 - (organization running log)
 - (8) how well bottom plugged Plug

DRILLERS REMARKS:
 AUG 20 1973

If well telescopes please sketch and show depths.

GROUND LEVEL

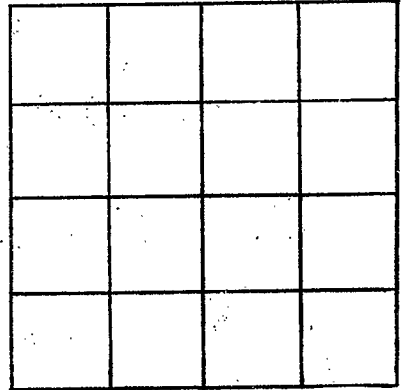

SECTION _____

Please indicate well location X.

ADDITIONAL INFORMATION

If more than one screen,
show locations of each on sketch.