

C 30
 WASHINGTON
 8-8-73

MISSISSIPPI
 BOARD OF WATER COMMISSIONERS
 416 North State Street
 Jackson, Mississippi 39201

CODED

WATER WELL DRILLERS LOG

8/14 1973 date well completed
 S. C. Drilling Wash. natural firm name county well located

LANDOWNER:	description of formations encountered	from	to
Darrell PARR Rt 2, Box 157 Leland Miss (mailing address)			
WELL LOCATION: sec. 6 T. 19 N. R. 6 E 7 miles N of Leland (distance) (direction) (nearest town)			
WELL PURPOSE: Home (home, irrigation, municipal, industrial)			
WELL COMPLETION DATA:			
(1) diameter (inches) 3"			
(2) total depth (feet) 514			523
(3) static water level (feet) 52 below top of ground.			
(4) casing Steel (material) (depth) (size) if telescope see back.			
(5) screen 10 (length) (depth to top) 3" (size) Sta. glass (material)			
(6) pump 1 (HP) 10 (yield gpm) Eka (type power)			
(7) electric log 710 (yes or no) (organization running log)			
(8) how well bottom plugged Special Valve			


CODED

DRILLERS REMARKS:

AUG 28 1973

If well telescopes please sketch and show depths.

GROUND LEVEL

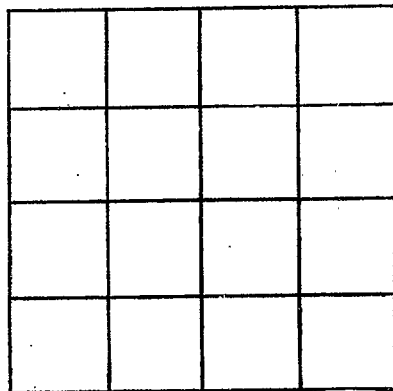

SECTION _____

Please indicate well location X.

ADDITIONAL INFORMATION

If more than one screen,
show locations of each on sketch.