

WASHINGTON
C31
2-28-74

MISSISSIPPI
 BOARD OF WATER COMMISSIONERS
 416 North State Street
 Jackson, Mississippi 39201

WATER WELL DRILLERS LOG

CODED

2-28 1974 date well completed
 Schultz Drilling Co firm name
 Washington county well located

LANDOWNER: Sub. Cont
 Joe New + Hugh oil co.
 (mailing address)

description of formations encountered	from	to
	Clay	0
Sand	23	85

WELL LOCATION:
 sec. 28 T. 19 N. R. 6 E
 5 miles N of Leland
 (distance) (direction) (nearest town)

WELL PURPOSE: Supply
 (home, irrigation, municipal, industrial)

CODED


- WELL COMPLETION DATA:
- diameter (inches) 4"
 - total depth (feet) 85
 - static water level (feet) 10 below top of ground.
 - casing P.V.C. 60 (material), (depth)
 (size) if telescope see back.
 - screen 25 (length), (depth to top)
 4" P.V.C. (size), (material)
 - pump None (HP), (yield gpm)
 (type power)
 - electric log no (yes or no)
 (organization running log)
 - how well bottom plugged Cap

DRILLERS REMARKS:

MISSISSIPPI
 BOARD OF WATER COMMISSIONERS
 JACKSON, MISSISSIPPI

If well telescopes please
sketch and show depths.

GROUND LEVEL

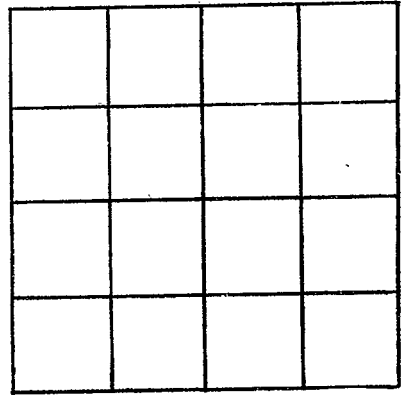

SECTION _____

Please indicate well location X.

ADDITIONAL INFORMATION

If more than one screen,
show locations of each on sketch.