

WASHINGTON
 C 3A
 3/1/78
 MS-GW 4566

MISSISSIPPI
 BOARD OF WATER COMMISSIONERS
 416 North State Street
 Jackson, Mississippi 39201

CODED

WATER WELL DRILLERS LOG

March 1, 1978 Deer Well & Irrigation Washington
 date well completed firm name county well located

LANDOWNER: Cook's Land & Farming Co.
 602 S.W. Deer Creek Drive
 Heland, Miss. 38756
 (mailing address)

description of formations encountered	from	to
Clay	0	32
FINE SAND	33	57
SAND + GRAVEL	58	103

WELL LOCATION:
 sec. 28 T. 10 N. R. 6 E.
 3 miles North of Elizabeth
 (distance) (direction) (nearest town)

Bottom 103/

WELL PURPOSE: Irrigation
 (home, irrigation, municipal, industrial)

- WELL COMPLETION DATA:
- (1) diameter (inches) 12"
 - (2) total depth (feet) 103'
 - (3) static water level (feet) 18' below top of ground.
 - (4) casing Steel, 63' (material) (depth)
 12" (size) if telescope see back.
 - (5) screen 40' length, 63' depth to top
 12" size, Steel material
 - (6) pump 100 HP, 1500-1800 yield gpm
 Diesel (type power)
 - (7) electric log No (yes or no)

(organization running log)
 (8) how well bottom plugged Plate

DRILLERS REMARKS:


Miss. Board of Water Comm.

FEB 8 1979

RECEIVED

If well telescopes please sketch and show depths.

GROUND LEVEL

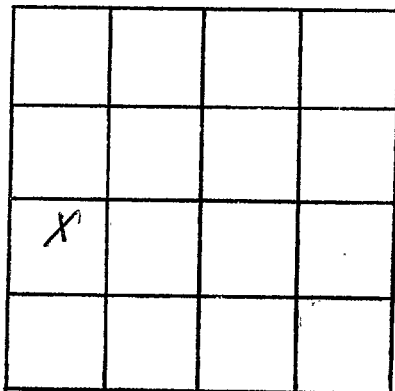

SECTION 28

Please indicate well location X.

ADDITIONAL INFORMATION

Lined area for additional information.

If more than one screen, show locations of each on sketch.