

WASHINGTON
 C 35
 3/1/78
 MS-GW 4571

MISSISSIPPI
 BOARD OF WATER COMMISSIONERS
 416 North State Street
 Jackson, Mississippi 39201

CODED

WATER WELL DRILLERS LOG

March 1 1978 Deer Well Irrigation Washington
 date well completed firm name county well located

LANDOWNER: Curtis Land & Farming Co
 602 S.W. Deer Creek Drive
 Leland, Miss. 39756
 (mailing address)

description of formations encountered	from	to
Clay	0	13
Clay	14	23
Clay	24	33
FINE SAND	34	58
SAND & GRAVEL	59	113
Bottom 113'		

WELL LOCATION:
 sec. 20 T. 10N R. 6E
 3 miles North of Elizabeth
 (distance) (direction) (nearest town)

WELL PURPOSE: Irrigation
 (home, irrigation, municipal, industrial)

- WELL COMPLETION DATA:
- diameter (inches) 16"
 - total depth (feet) 113'
 - static water level (feet) 18' below top of ground.
 - casing Steel, 73' (material) (depth)
 16" if telescope see back. (size)
 - screen 40, 73' (length) (depth to top)
 16", Steel (size) (material)
 - pump 60, 3000 (HP) (yield gpm)
 Diesel (type power)
 - electric log No (yes or no)
 - (organization running log)
 - how well bottom plugged Plate

DRILLERS REMARKS:


Miss. Board of Water Comm.

FEB 8 1978

RECEIVED

If well telescopes please sketch and show depths.

GROUND LEVEL

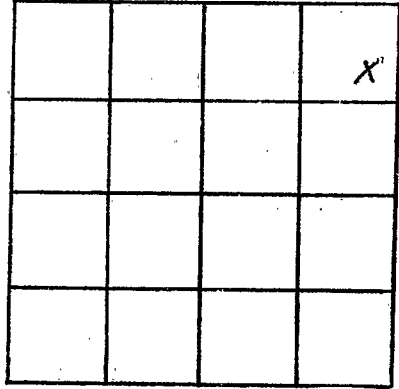

SECTION 20

Please indicate well location X.

ADDITIONAL INFORMATION

If more than one screen,
show locations of each on sketch.