

WASHINGTON
 CL-1037 C 36
~~3-23-77~~
 11-1-78

MISSISSIPPI
 BOARD OF WATER COMMISSIONERS
 416 North State Street
 Jackson, Mississippi 39201

CODED

WATER WELL DRILLERS LOG

11-1 1978 LAYNE CENTRAL COMPANY WASHINGTON
 date well completed firm name county well located

LANDOWNER: Ray Beckham
 Ieland, MS

description of formations encountered	from to	
clay	0	12
fine sand	12	22
med. sand	22	32
coarse sand & pea gr.	32	42
c. sand & pea gravel & big gravel	42	122

(mailing address)

WELL LOCATION:
 sec. 9 T. 19 S. R. 6 E
 7 miles N of Ieland
 (distance) (direction) (nearest town)

WELL PURPOSE: Irrigation
 (home, irrigation, municipal, industrial)

WELL COMPLETION DATA:

(1) diameter (inches) 16"
 (2) total depth (feet) 122'
 (3) static water level (feet) 21 ^{below} top of ground.
 (4) casing Steel 72' (material) (depth) 16" (size) If telescope see back.
 (5) screen 50' 72' (length) (depth to top) 16" St. Steel (size) (material)
 (6) pump 60 2500 (HP) (yield gpm) diesel (type power)
 (7) electric log no (yes or no)
 (organization running log)
 (8) how well bottom plugged St. Plate

DRILLERS REMARKS:

CODED


Miss. Board of Water Control

MAR 27 1978

RECEIVED

If well telescopes please sketch and show depths.

GROUND LEVEL

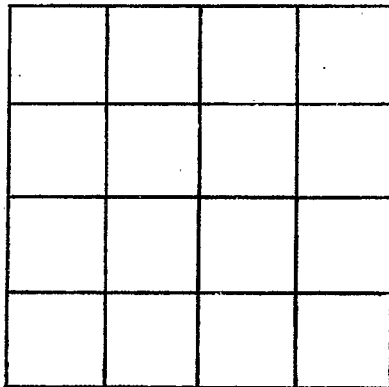

SECTION _____

Please indicate well location X.

ADDITIONAL INFORMATION

If more than one screen, show locations of each on sketch.