

MISSISSIPPI DEPARTMENT OF NATURAL RESOURCES

Bureau of Land and Water Resources

Southport Mall

P.O. Box 10631

Jackson, Mississippi 39209

WATER WELL DRILLERS LOG

Wash
C40
4-3-81

April 03 1981 date well completed
Larry's well & Pump firm name
Washington county well located

LANDOWNER: <u>Wilson Perren</u>	description of formations encountered	CODED	from	to
<u>Seland ms</u> (mailing address)	CLAY		0	90
	MED SAND		70	85
	CORSE SAND		85	123


WELL LOCATION:
sec. 17 T. 19 N R. 6 E
7 miles N of Seland
(distance) (direction) (nearest town)

WELL PURPOSE:
(home, irrigation, municipal, industrial)

WELL COMPLETION DATA:


- (1) diameter (inches) 16"
- (2) total depth (feet) 123'
- (3) static water level (feet) 20 below above top of ground.
- (4) casing Steel, 83'
(material) (depth)
(size) if telescope see back.
- (5) screen 40', 83'
(length) (depth to top)
16", Steel
(size) (material)
- (6) pump 60, 3000
(HP) (yield gpm)
Elec
(type power)
- (7) electric log No
(yes or no)
(organization running log)
- (8) how well bottom plugged Steel Plate

DRILLERS REMARKS:

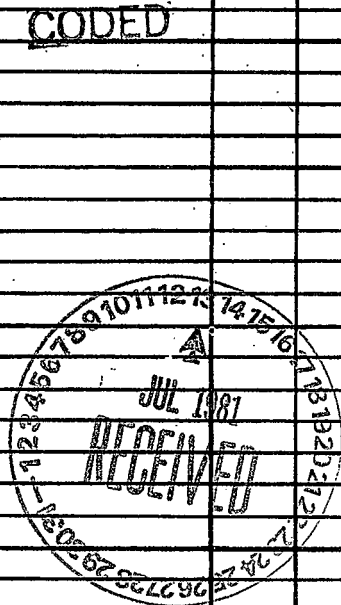

If well telescopes please
sketch and show depths.

GROUND LEVEL

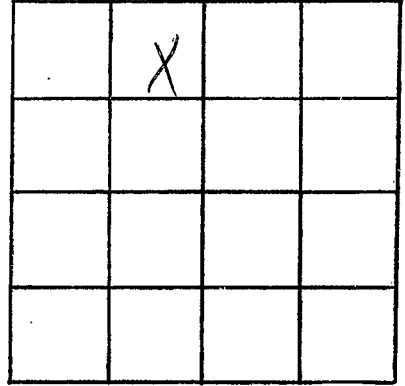

SECTION 17

Please indicate well location X.

ADDITIONAL INFORMATION

If more than one screen,
show locations of each on sketch.