

MISSISSIPPI DEPARTMENT OF NATURAL RESOURCES

Bureau of Land and Water Resources

Southport Mall

P.O. Box 10631

Jackson, Mississippi 39209

WATER WELL DRILLERS LOG

CODED

Washington
C 42
4/3/82

date well completed 19 1982 firm name Dyer Well + Service county well located Washington

LANDOWNER: <u>Charles Nelson</u>	description of formations encountered	from	to
(mailing address)	<u>Clay</u> <u>fine sand</u> <u>sand + gravel</u>	<u>0</u> <u>34</u> <u>40</u>	<u>211</u> <u>40</u> <u>103</u>
WELL LOCATION: sec. <u>6</u> T <u>R</u> N <u>6</u> E <u>8</u> miles <u>NE</u> of <u>Leard</u> (distance) (direction) (nearest town)			
WELL PURPOSE: (home, irrigation, municipal, industrial)			
WELL COMPLETION DATA:	CODED		
(1) diameter (inches) <u>16</u>			
(2) total depth (feet) <u>103</u>			
(3) static water level (feet) <u>27</u> below above top of ground.			
(4) casing <u>Steel</u> , <u>63</u> (material) (depth)			
_____ if telescope see back. (size)			
(5) screen <u>40'</u> , <u>40'</u> (length) (depth to top)			
<u>16"</u> , <u>steel</u> (size) (material)			
(6) pump <u>40</u> , <u>2000</u> (HP) (yield gpm)			
<u>diesel</u> (type power)			
(7) electric log <u>no</u> (yes or no)			
_____ <u>no</u> (organization running log)			
(8) how well bottom plugged <u>plate</u>			
DRILLERS REMARKS:			


DEPT. OF NATURAL RESOURCES
 BUREAU OF LAND & WATER RESOURCES

FEB - 3 1983

RECEIVED

If well telescopes please sketch and show depths.

GROUND LEVEL

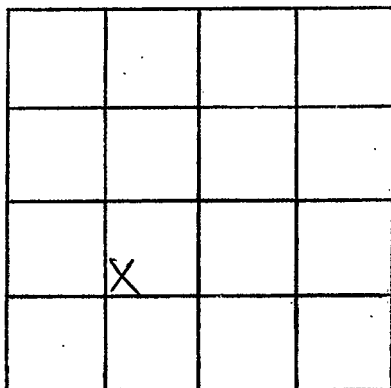

SECTION 6

Please indicate well location X.

ADDITIONAL INFORMATION

If more than one screen,
show locations of each on sketch.