

MISSISSIPPI DEPARTMENT OF NATURAL RESOURCES

Bureau of Land and Water Resources

Southport Mall

P.O. Box 10631

Jackson, Mississippi 39209

WATER WELL DRILLERS LOG

CODED

Washington
C 43
5-1-93

date well completed May 01 19 83 firm name Lewis well pump county well located Washington Co

LANDOWNER: <u>Maurice Brown</u>	description of formations encountered	from	to
<u>Leland mo.</u> (mailing address)	<u>Clay</u>	<u>0</u>	<u>20</u>
	<u>Silt</u>	<u>20</u>	<u>50</u>
	<u>Sand + gravel</u>	<u>50</u>	<u>150</u>
WELL LOCATION:			
sec. <u>19</u> T. <u>19</u> N R. <u>6</u> E S <u>6</u> W <u>5</u> miles <u>North</u> of <u>Leland</u> (distance) (direction) (nearest town)			
WELL PURPOSE:			
(home, irrigation, municipal, industrial)			
WELL COMPLETION DATA:			
(1) diameter (inches) <u>16"</u>			
(2) total depth (feet) <u>100'</u>			
(3) static water level (feet) <u>20</u> ^{below} / _{above} top of ground.			
(4) casing <u>Steel</u> , <u>60'</u> (material) (depth)			
(size) If telescope see back.			
(5) screen <u>40'</u> , <u>60'</u> (length) (depth to top)			
<u>16"</u> , <u>steel</u> (size) (material)			
(6) pump <u>80</u> , <u>1200</u> (HP) (yield gpm)			
(type power)			
(7) electric log <u>No</u> (yes or no)			
(organization running log)			
(8) how well bottom plugged <u>Steel</u> <u>Plate</u>			
DRILLERS REMARKS:			


CODED

DEPT. OF NATURAL RESOURCES
 BUREAU OF LAND & WATER RESOURCES

SEP 26 1983
 RECEIVED

If well telescopes please sketch and show depths.

GROUND LEVEL

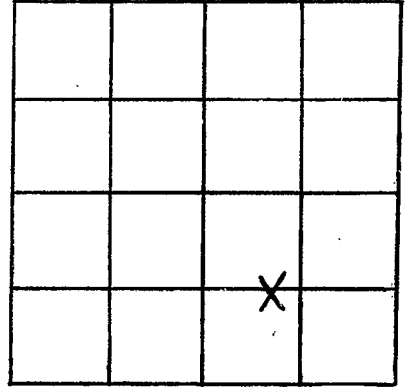

SECTION 19

Please indicate well location X.

ADDITIONAL INFORMATION

If more than one screen,
show locations of each on sketch.