

MISSISSIPPI DEPARTMENT OF NATURAL RESOURCES

Bureau of Land and Water Resources

Southport Mall

P.O. Box 10631

Jackson, Mississippi 39209

WATER WELL DRILLERS LOG

CODED

C 44

5-1-83

May 01, 1983 date well completed
 Larry's well & pump firm name
 Washington county well located

LANDOWNER: <u>Maurice Brown</u>	description of formations encountered	from	to
<u>Leland Ms</u> (mailing address)	<u>clay</u>	<u>6</u>	<u>20</u>
	<u>Sand</u>	<u>20</u>	<u>50</u>
	<u>Sand & gravel</u>	<u>50</u>	<u>100</u>
CODED			
WELL LOCATION: sec. <u>19</u> T. <u>19</u> N R. <u>—</u> E S <u>6</u> W <u>5</u> miles <u>North</u> of <u>Leland</u> (distance) (direction) (nearest town)			
WELL PURPOSE: (home, irrigation, municipal, industrial)			
WELL COMPLETION DATA:			
(1) diameter (inches) <u>16"</u>			
(2) total depth (feet) <u>100'</u>			
(3) static water level (feet) <u>20'</u> ^{below} / _{above} top of ground.			
(4) casing <u>Steel</u> , <u>60'</u> (material) (depth) (size) if telescope see back.			
(5) screen <u>40'</u> , <u>60'</u> (length) (depth to top)			
<u>16"</u> , <u>Steel</u> (size) (material)			
(6) pump <u>80</u> , <u>1200</u> (HP) (yield gpm)			
(type power)			
(7) electric log <u>No</u> (yes or no)			
(organization running log)			
(8) how well bottom plugged <u>Steel Plate</u>			
DRILLERS REMARKS:			


DEPT. OF NATURAL RESOURCES
 BUREAU OF LAND & WATER RESOURCES

SEP 26 1983

RECEIVED

If well telescopes please
sketch and show depths.

GROUND LEVEL

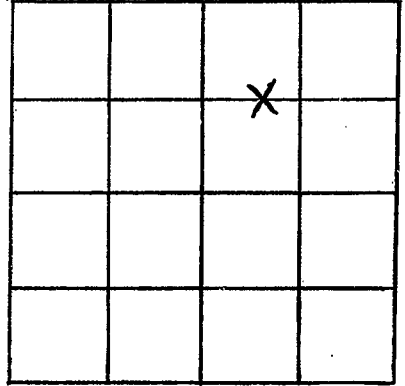

SECTION 19

Please indicate well location X.

ADDITIONAL INFORMATION

If more than one screen;
show locations of each on sketch.