

MISSISSIPPI DEPARTMENT OF NATURAL RESOURCES

Bureau of Land and Water Resources

Southport Mall

P.O. Box 10631

Jackson, Mississippi 39209

CODED

WATER WELL DRILLERS LOG

C 45
Washington
12-17-83
MS-GW 4567
12-17 1983

date well completed 12-17 1983 firm name Schultz Drilling county well located Washington

LANDOWNER: Mark Curtis
Leland MS

description of formations encountered

from to

(mailing address)

Clay	0	18
COARSE SAND	18	40
COARSE SAND and	40	80
PEA GRAVEL		
COARSE SAND + GRAVEL	80	110

WELL LOCATION:

sec. 20 T. 19 N. R. 6 E. S. 4 miles N of Leland
(distance) (direction) (nearest town)

WELL PURPOSE: IRRIGATION
(home, irrigation, municipal, industrial)

CODED

WELL COMPLETION DATA:

- (1) diameter (inches) 16"
- (2) total depth (feet) 110'
- (3) static water level (feet) 18' -below above top of ground.
- (4) casing PVC 70'
(material) (depth)
- (size) if telescope see back.
- (5) screen 40' 70'
(length) (depth to top)
- 16" PVC
(size) (material)
- (6) pump Ø estimated 3000
(HP) (yield gpm)
- Ø
(type power)
- (7) electric log NO
(yes or no)
NONE
(organization running log)
- (8) how well bottom plugged PVC CAP

DEPT. OF NATURAL RESOURCES
BUREAU OF LAND & WATER RESOURCES


JAN 12 1984

RECEIVED

DRILLERS REMARKS:

If well telescopes please sketch and show depths.

GROUND LEVEL

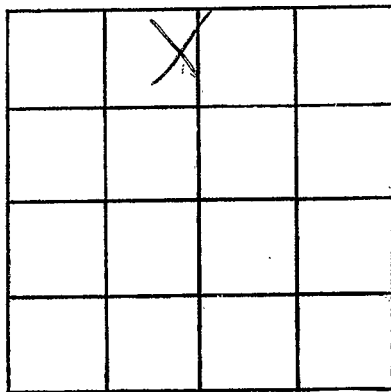

SECTION 20

Please indicate well location X.

ADDITIONAL INFORMATION

If more than one screen,
show locations of each on sketch.