

WASHINGTON

C 47

MISSISSIPPI DEPARTMENT OF NATURAL RESOURCES

Bureau of Land and Water Resources

Southport Mall

P.O. Box 10631

Jackson, Mississippi 39209

WATER WELL DRILLERS LOG

CODED

March 14

1984

Larry's well & pump

firm name

Washington

county well located

LANDOWNER:

John Picialisi

description of formations encountered

from

to

Leland miss

(mailing address)

Clay

S.S.D

Sand + gravel

0 30

30 50

50 100

WELL LOCATION:

sec 28 T 19 N

R E

S

6 W

6

miles NE

of

Leland

(distance)

(direction)

(nearest town)

WELL PURPOSE:

(home, irrigation, municipal, industrial)

WELL COMPLETION DATA:

CODED

(1) diameter (inches)

16"

(2) total depth (feet)

100'

(3) static water level (feet)

22

below above top of ground.

(4) casing

Steel

60'

(material)

(depth)

(size) if telescope see back.

(5) screen

40'

100'

(length)

(depth to top)

16"

(size)

Steel

(material)

(6) pump

60

(HP)

1200

(yield gpm)

D

(type power)

(7) electric log

NO (yes or no)

(organization running log)

(8) how well bottom plugged

Steel Plate

DRILLERS REMARKS:


DEPT. OF NATURAL RESOURCES BUREAU OF LAND & WATER RESOURCES

AUG 23 1984

RECEIVED

If well telescopes please sketch and show depths.

GROUND LEVEL

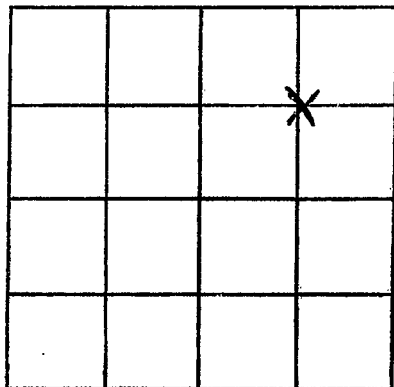

SECTION 28

Please indicate well location X.

ADDITIONAL INFORMATION

If more than one screen,
show locations of each on sketch.