

MISSISSIPPI DEPARTMENT OF NATURAL RESOURCES

Bureau of Land and Water Resources

Southport Mall

P.O. Box 10631

Jackson, Mississippi 39209

WATER WELL DRILLERS LOG

CODED

WASHINGTON  
C 48  
MS-GW 4945

March 19 1984 Larrin's well pump Washington  
date well completed firm name county well located

LANDOWNER: <u>Maurice Brown</u>	description of formations encountered	from	to
<u>Leland miss</u> (mailing address)	<u>clay</u> <u>Sand</u> <u>Sand &amp; gra.</u>	<u>0</u> <u>30</u> <u>30</u> <u>50</u> <u>80</u> <u>100</u>	<u>30</u> <u>50</u> <u>100</u>
WELL LOCATION: sec <u>20</u> T <u>19</u> N R <u>6</u> E S W <u>5</u> miles N of <u>Leland</u> (distance) (direction) (nearest town)			
WELL PURPOSE: (home, irrigation, municipal, industrial)			
WELL COMPLETION DATA:			
(1) diameter (inches) <u>12"</u>			
(2) total depth (feet) <u>100'</u>			
(3) static water level (feet) <u>23</u> below above top of ground.			
(4) casing <u>Steel</u> , <u>60'</u> , (material) (depth)			
(size) If telescope see back.			
(5) screen <u>40'</u> , <u>60'</u> (length) (depth to top)			
<u>12"</u> , <u>Steel</u> (size) (material)			
(6) pump <u>60</u> , <u>1200</u> (HP) (yield gpm)			
<u>P</u> (type power)			
(7) electric log <u>No</u> (yes or no)			
(organization running log)			
(8) how well bottom plugged <u>Steel</u> <u>Plate</u>			
DRILLERS REMARKS:			

CODED


DEPT. OF NATURAL RESOURCES  
BUREAU OF LAND & WATER RESOURCES

AUG 23 1984

RECEIVED

If well telescopes please sketch and show depths.

GROUND LEVEL

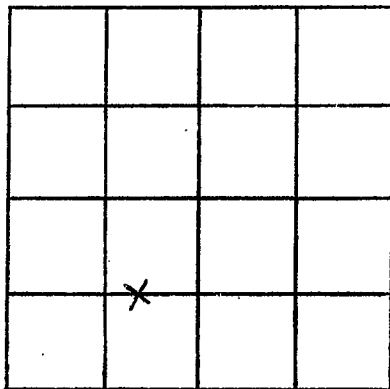

SECTION 20

Please indicate well location X.

ADDITIONAL INFORMATION

If more than one screen, show locations of each on sketch.