

MISSISSIPPI DEPARTMENT OF NATURAL RESOURCES

Bureau of Land and Water Resources

Southport Mall

P.O. Box 10631

Jackson, Mississippi 39209

WATER WELL DRILLERS LOG

CODED

WASHINGTON
C49
MS-GW 4944

March 15 1984
date well completed

Lanning Well & Pump
firm name

Washington
county well located

LANDOWNER: <u>Maurice Brown</u>	description of formations encountered	from	to
<u>Leland, MS</u> (mailing address)	<u>clay</u>	0	30
	<u>Sand</u>	3'	50
	<u>Sand & gravel</u>	50	100
WELL LOCATION:			
sec. <u>20</u> T. <u>19</u> N. R. <u>6</u> E. S. <u>6</u> W. <u>5</u> miles <u>W</u> of <u>Leland</u> (distance) (direction) (nearest town)	CODED		
WELL PURPOSE: (home, irrigation, municipal, industrial)			
WELL COMPLETION DATA:			
(1) diameter (inches) <u>12"</u>			
(2) total depth (feet) <u>100'</u>			
(3) static water level (feet) <u>23</u> <u>below</u> above top of ground.			
(4) casing <u>Steel</u> , <u>60'</u> (material) (depth)			
<u> </u> if telescope see back. (size)			
(5) screen <u>40'</u> , <u>60'</u> (length) (depth to top)			
<u>12"</u> , <u>Steel</u> (size) (material)			
(6) pump <u>60</u> , <u>1000</u> (HP) (yield gpm)			
<u> </u> (type power)			
(7) electric log <u>no</u> (yes or no)			
<u> </u> (organization running log)			
(8) how well bottom plugged <u>Steel Plate</u>			
DRILLERS REMARKS:			


DEPT. OF NATURAL RESOURCES
BUREAU OF LAND & WATER RESOURCES

AUG 23 1984

RECEIVED

If well telescopes please sketch and show depths.

GROUND LEVEL

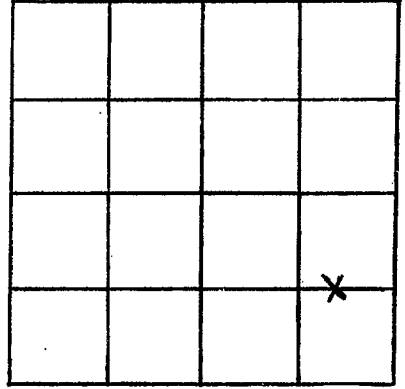

SECTION 20

Please indicate well location X.

ADDITIONAL INFORMATION

If more than one screen,
show locations of each on sketch.