

MISSISSIPPI DEPARTMENT OF NATURAL RESOURCES

Bureau of Land and Water Resources

Southport Mall

P.O. Box 10631

CODED

Jackson, Mississippi 39209

13

WATER WELL DRILLERS LOG

WASHINGTON
C 50

April 11 1984 Larry's well & pump Washington
date well completed mm name county well located


LANDOWNER:	description of formations encountered	from	to
Charles Frateris			
Leland, Ma (mailing address)	slay Fine Sand course Sandstone	0 30 60	30 60 116
WELL LOCATION: sec. 7 T 19 N S R E 7 miles N of Leland (distance) (direction) (nearest town)			
WELL PURPOSE: (home, irrigation, municipal, industrial)			
WELL COMPLETION DATA:			
(1) diameter (inches) 16"			
(2) total depth (feet) 116'			
(3) static water level (feet) 24' below top of ground.			
(4) casing Steel, 76' (material) (depth)			
(size) If telescope see back.			
(5) screen 40', 76' (length) (depth to top)			
16", Steel (size) (material)			
(6) pump 60 2500 (HP) (yield gpm)			
D (type power)			
(7) electric log no (yes or no)			
(organization running log)			
(8) how well bottom plugged Steel Plate			
DRILLERS REMARKS:			

CODED

DEPT. OF NATURAL RESOURCES
BUREAU OF LAND & WATER RESOURCES
RECEIVED
AUG 28 1984

If well telescopes please sketch and show depths.

GROUND LEVEL

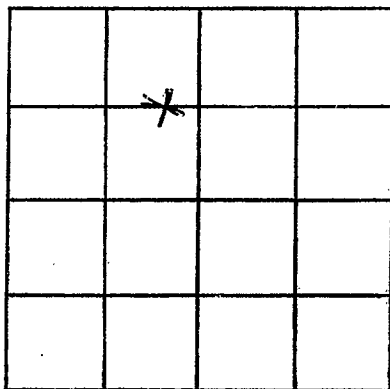

SECTION 7

Please indicate well location X.

ADDITIONAL INFORMATION

If more than one screen, show locations of each on sketch.