

WASHINGTON
 CI-2929 C51

MISSISSIPPI DEPARTMENT OF NATURAL RESOURCES
 Bureau of Land and Water Resources
 Southport Mall
 P.O. Box 10631
 Jackson, Mississippi 39209
WATER WELL DRILLERS LOG

CODED

5-24 1985 LAYNE-CENTRAL CO. WASHINGTON
 date well completed firm name county well located

LANDOWNER:
BECKHAM FARMS
SHAW, MS
 (mailing address)

description of formations encountered	from	to
clay	0	16
fine sand	16	32
coarse sand	32	52
coarse sand/gravel	52	122
coarse sand/gravel/clay	122	123

WELL LOCATION: #3
 sec 3 T 19 N R 6 W
5 miles SE of Shaw
 (distance) (direction) (nearest town)

CODED

WELL PURPOSE: irrigation
 (home, irrigation, municipal, industrial)

WELL COMPLETION DATA:

(1) diameter (inches) 32"

(2) total depth (feet) 123'

(3) static water level (feet) 21' below above top of ground.

(4) casing steel 73'
 (material) (depth)
16" if telescope see back.
 (size)

(5) screen 50' 73'
 (length) (depth to top)
16" st. steel
 (size) (material)

(6) pump 60 3000
 (HP) (yield gpm)
diesel
 (type power)

(7) electric log no
 (yes or no)
st. plate
 (organization running log)

(8) how well bottom plugged


RECEIVED
 JUL 8 - 1995

DRILLERS REMARKS:

Department of Natural Resources
 Bureau of Land & Water Resources

If well telescopes please sketch and show depths.

GROUND LEVEL

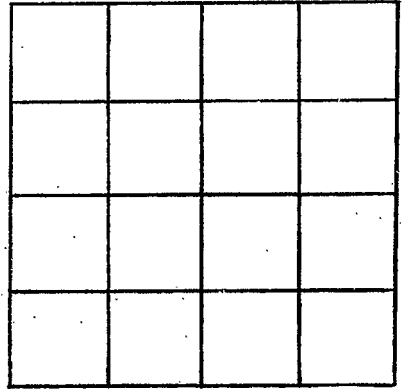

SECTION _____

Please indicate well location X.

ADDITIONAL INFORMATION

If more than one screen,
show locations of each on sketch.