

MISSISSIPPI DEPARTMENT OF NATURAL RESOURCES
 Bureau of Land and Water Resources
 Southport Mall
 P.O. Box 10631
 Jackson, Mississippi 39209
WATER WELL DRILLERS LOG

CODED

WASHINGTON
~~BOLIVAR~~
 CT-2804 C.52

WASHINGTON
~~BOLIVAR~~

7/16 19 84 LAYNE-CENTRAL CO. date well completed firm name county well located

LANDOWNER:
 BECKHAM FARMS, INC.
 SHAW, MS
 (mailing address)

description of formations encountered	from	to
clay	0	16
coarse sand	16	30
coarse sand/gravel	30	100

WELL LOCATION:
 sec. 9 T. 19 N. R. 6 W.
 1 miles N of Helm
 (distance) (direction) (nearest town)

CODED

WELL PURPOSE: irrigation
 (home, irrigation, municipal, industrial)

WELL COMPLETION DATA:

- (1) diameter (inches) 6"
- (2) total depth (feet) 97'
- (3) static water level (feet) 19' below top of ground.
- (4) casing pvc, 77' (material), (depth), 4" (size) if telescope see back.
- (5) screen 20', 77' (length), (depth to top), 4" pvc (size), (material)
- (6) pump 1/2 HP, 10 (yield gpm), elec. (type power)
- (7) electric log no (yes or no)
- (organization running log) pvc plug
- (8) how well bottom plugged


RECEIVED

JUL 9 - 1984

DRILLERS REMARKS:

If well telescopes please sketch and show depths.

GROUND LEVEL

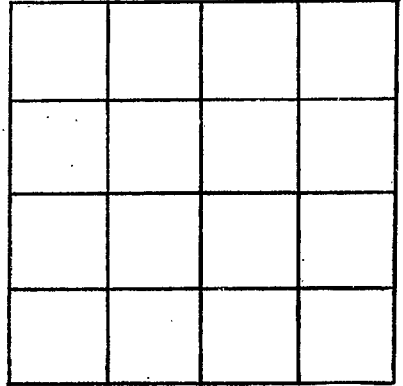

SECTION _____

Please indicate well location X.

ADDITIONAL INFORMATION

If more than one screen, show locations of each on sketch.