

MISSISSIPPI DEPARTMENT OF NATURAL RESOURCES

Bureau of Land and Water Resources

Southport Mall

P.O. Box 10631

Jackson, Mississippi 39209

WATER WELL DRILLERS LOG

CODED

WASHAWAN
C 53

7-11 1985 Scheltz Drilling WASH.
date well completed firm name county well located

LANDOWNER: MARIE CURTIS
Hwy 61
Leland MS
(mailing address)

description of formations encountered	from	to
CLAY	0	20
SAND	20	100

WELL LOCATION:
sec 20 T 19 N R 6 E
4 miles N of Leland
(distance) (direction) (nearest town)

WELL PURPOSE: IRRIGATION
(home, irrigation, municipal, industrial)

WELL COMPLETION DATA:

(1) diameter (inches) 8"

(2) total depth (feet) 100

(3) static water level (feet) 21' below above top of ground.

(4) casing PVC 80'
(material) (depth)

(size) if telescope see back.

(5) screen 20' 80'
(length) (depth to top)

8" PVC
(size) (material)

(6) pump 10 500
(HP) (yield gpm)

ele
(type power)

(7) electric log no
(yes or no)

X
(organization running log)

(8) how well bottom plugged CAI


CODED

RECEIVED
DEC 3 - 1985

DRILLERS REMARKS:

If well telescopes please sketch and show depths.

GROUND LEVEL

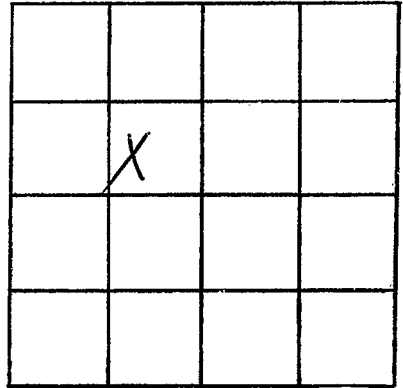

SECTION 20

Please indicate well location X.

ADDITIONAL INFORMATION

If more than one screen,
show locations of each on sketch.