

MISSISSIPPI DEPARTMENT OF NATURAL RESOURCES

Bureau of Land and Water Resources

Southport Mall

P.O. Box 10631

Jackson, Mississippi 39209

WATER WELL DRILLERS LOG


CODED

WASHINGTON
C 54

4-1-86 19 Schultz Drilling Washington
date well completed firm name county well located

LANDOWNER: MARC CURTIS P.O. Box 958	description of formations encountered	from	to
Leland MS (mailing address)	CLAY SAND SAND + GRAVEL	0 20 20 60 60 100	20 60 100
<p>WELL LOCATION:</p> <p>sec. 20 T 19 N R 6 E 4 miles N of Leland (distance) (direction) (nearest town)</p>			
<p>WELL PURPOSE: IRRIGATION (home, irrigation, municipal, industrial)</p>			
<p>WELL COMPLETION DATA:</p>			
<p>(1) diameter (inches) 16"</p>			
<p>(2) total depth (feet) 100</p>			
<p>(3) static water level (feet) 21' below above top of ground.</p>			
<p>(4) casing PVC 60' (material) (depth)</p>			
<p>if telescope see back.</p>			
<p>(5) screen 40' 60' (length) (depth to top)</p>			
<p>16" PVC (size) (material)</p>			
<p>(6) pump 60 3000 (HP) (yield gpm)</p>			
<p>PTO (type power)</p>			
<p>(7) electric log NO (yes or no)</p>			
<p>K (organization running log)</p>			
<p>(8) how well bottom plugged CAP</p>			
<p>DRILLERS REMARKS:</p>			


CODED

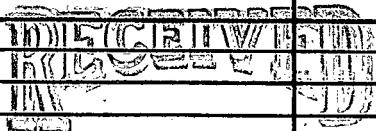

Department of Natural Resources
Bureau of Land & Water Resources

If well telescopes please sketch and show depths.

GROUND LEVEL

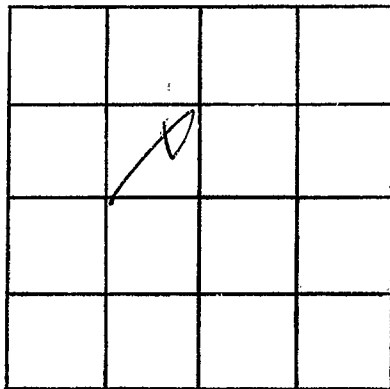

SECTION 20

Please indicate well location X.

ADDITIONAL INFORMATION

If more than one screen,
show locations of each on sketch.