

MISSISSIPPI DEPARTMENT OF NATURAL RESOURCES

Bureau of Land and Water Resources

Southport Mall

P.O. Box 10631

Jackson, Mississippi 39209

WATER WELL DRILLERS LOG

CODED

WASHINGTON
C55
MS-GW 1386

Jan. 06 1986 Larry's wells & pump Washington
date well completed firm name county well located


LANDOWNER: Maurice Brown
Leland, mo
(mailing address)
WELL LOCATION:
sec. 32 T 19 N R 6 E
4 miles N of Leland
(distance) (direction) (nearest town)

description of formations encountered	from	to
Clay	0	30
Finest Sand	30	50
loose Sand & gravel	50	108

CODED

WELL PURPOSE:
(home, irrigation, municipal, industrial)

WELL COMPLETION DATA:
(1) diameter (inches) 16"
(2) total depth (feet) 108'
(3) static water level (feet) 82 below top of ground.
(4) casing Steel, 68' (material) (depth)
(size) If telescope see back.
(5) screen 40' 68' (length) (depth to top)
16" Steel (size) (material)
(6) pump 100 1200 (HP) (yield gpm)
D (type power)
(7) electric log No (yes or no)
(organization running log)
(8) how well bottom plugged Steel Plate

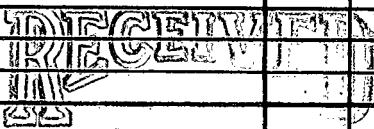


SEP 25 1986

Department of Natural Resources
Bureau of Land & Water Resources

DRILLERS REMARKS:

If well telescopes please sketch and show depths.

GROUND LEVEL

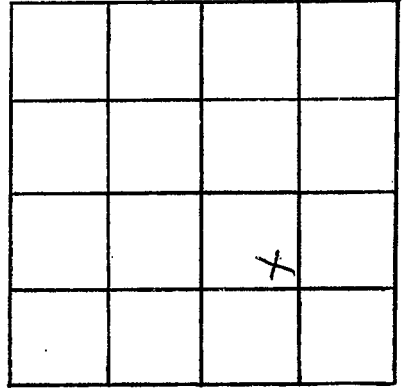

SECTION 32

Please indicate well location X.

ADDITIONAL INFORMATION

If more than one screen,
show locations of each on sketch.