


If well telescopes please sketch and show depths.

GROUND LEVEL

IRRIGATION EQUIPMENT
C01/000-2355
INDIANOLA, MS

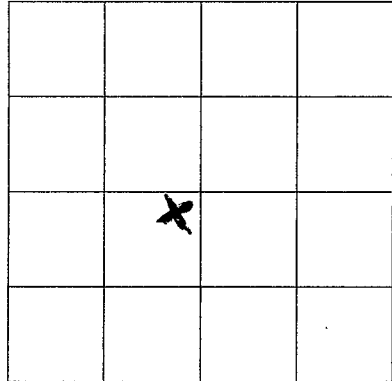

SECTION 25

Please indicate well location X.

ADDITIONAL INFORMATION

If more than one screen,
show location of each on sketch.