

Washington  
C 57  
146 B

MISSISSIPPI DEPARTMENT OF NATURAL RESOURCES  
 Bureau of Land and Water Resources  
 Southport Mall  
 P.O. Box 10631  
 Jackson, Mississippi 39209

Coded

WATER WELL DRILLERS LOG

9-25 1987 Schultz Drilling Washington  
 date well completed firm name county well located

LANDOWNER: MARC CURTIS  
P.O. 958  
Leland MS  
 (mailing address)

description of formations encountered	from	to
<u>CLAY</u>	<u>0</u>	<u>18</u>
<u>SAND</u>	<u>18</u>	<u>70</u>
<u>SAND + GRAVEL</u>	<u>70</u>	<u>100</u>

WELL LOCATION:  
 sec. 30 T. 19 N. R. 6 E  
3 miles N. of Leland  
 (distance) (direction) (nearest town)

WELL PURPOSE: FERTIGATION  
 (home, irrigation, municipal, industrial)

- WELL COMPLETION DATA:
- (1) diameter (inches) 12"
  - (2) total depth (feet) 100'
  - (3) static water level (feet) 31' below above top of ground.
  - (4) casing PVC 60'  
 (material) (depth)
  - if telescope see back.  
 (size)
  - (5) screen 40' 60'  
 (length) (depth to top)
  - 12" PVC  
 (size) (material)
  - (6) pump 40 2000  
 (HP) (yield gpm)
  - ele  
 (type power)
  - (7) electric log no  
 (yes or no)
  - X  
 (organization running log)
  - (8) how well bottom plugged plap

**RECEIVED**


OCT 28 1987

Department of Natural Resources  
 Bureau of Land & Water Resources

DRILLERS REMARKS:  
 \_\_\_\_\_  
 \_\_\_\_\_  
 \_\_\_\_\_

If well telescopes please sketch and show depths.

GROUND LEVEL

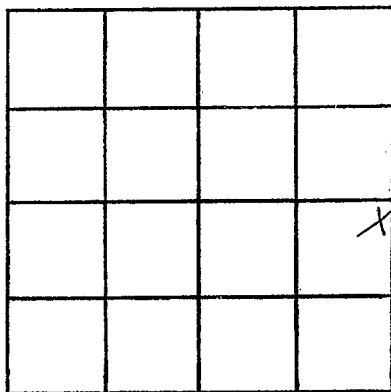

SECTION 30

Please indicate well location X.

ADDITIONAL INFORMATION

If more than one screen,  
show locations of each on sketch.