

MISSISSIPPI DEPARTMENT OF NATURAL RESOURCES

Bureau of Land and Water Resources

P.O. Box 10631

Jackson, Mississippi 39209

WATER WELL DRILLERS LOG

COUNTY WELL LOCATED Washington	
WELL NUMBER C 58	CODED <input checked="" type="checkbox"/>
DATE WELL COMPLETED 4-24-88	

PERMIT NUMBER 8754
NAME OF DRILLING FIRM IRRIGATION EQUIPMENT
PHONE NUMBER 601/887-2555
LOCATION INDIANOLA, MS

NAME & MAILING ADDRESS OF LANDOWNER SHady Bayou Farm		
514 ARNOLD AVE.		
Greenville, MS 38701		
WELL LOCATION: SEC	TOWNSHIP	RANGE
128D	26	19
	N	E
	S	W
	6	
DISTANCE	DIRECTION	NEAREST TOWN
8 Miles	NE	of Leland
OTHER LANDMARK		
WELL PURPOSE: Home, Irrigation, Municipal, Industrial, Fish Pond, etc. IRRIGATION		

PUMP DATA		
PUMP TYPE (Circle One): Submersible, <u>Turbine</u> , Jet, Flowing Well, Other (Describe) _____		
POWER TYPE (Circle One): Electric, Tractor, <u>Diesel</u> , Gasoline, Butane, Other (Describe) _____		
Pump Capacity (GPM)	No. of Stages	Setting Depth
1250	3	60 FT.
PUMP TEST		
Well yielded _____ GPM with a drawdown of _____ ft. after _____ hours of pumping		

WELL DATA		
Well Depth 98	Casing Diameter (In.) 16	Casing Length (Ft.) 58
Type of Casing PVC	Hole Depth 98	Depth to Static Water Level 28'
TYPE OF COMPLETION: (Circle One or More): <u>Gravel Packed</u> , Underreamed, Telescoped, Natural Development, Open Hole, Other		
Top of Lap Pipe or Reduction in Casing		
FEET		IF TELESCOPED OR MORE THAN ONE SCREEN: USE BACK PAGE


LOG DATA	
TYPE OF LOG RUN (Circle One): No Log Run, Electric, Gamma Ray, Density, Sonic, Neutron, Other (Describe) _____	
Name of Organization Running Log	

SCREEN DATA		
Diameter - Inches 16	Length - Feet 40	Slot Size - Inches .050
Screen Type PVC	Depth to Bottom - Feet 40	

GEOLOGIC DATA (Office Use Only)			
Surface Elev.	Geologic Unit	Unit Thickness	Depth to Top
Subs. SWL	Date	Analysis	Aquifer Test
Driller's Remarks			

DESCRIPTION OF FORMATIONS ENCOUNTERED	FROM	TO
FINE SAND	0	18
COARSE SAND	18	58
COARSE SAND with GRAVEL	58	98

INFORMATION (Continued)		FROM	TO
APR 29 1988			
Department of Natural Resources Bureau of Land & Water Resources			
IF MORE SPACE IS NEEDED, USE BACK			

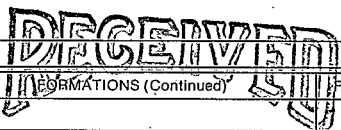

If well telescopes please
sketch and show depths.

GROUND LEVEL

IRRIGATION EQUIPMENT
601/887-2555
INDIANOLA, MS

X			

SECTION 26

Please indicate well location X.

ADDITIONAL INFORMATION

If more than one screen,
show location of each on sketch.