

MISSISSIPPI DEPARTMENT OF NATURAL RESOURCES

Bureau of Land and Water Resources

Southport Mall

P.O. Box 10631

Jackson, Mississippi 39209

WATER WELL DRILLERS LOG

Permit  
Applied For  
C 62

5-2 1988 Dyer Well Washington  
date well completed firm name county well located

LANDOWNER: Hill Farms  
RT 2 Box 340  
Indianola Ms 38751  
(mailing address)

WELL LOCATION:  
sec 12 T 19 N R 6 E  
15 miles NW Indianola  
(distance) (direction) (nearest town)

WELL PURPOSE: Irrigation  
(home, irrigation, municipal, industrial)

WELL COMPLETION DATA:

- (1) diameter (inches) 12"
- (2) total depth (feet) 105'
- (3) static water level (feet) \_\_\_\_\_ below above top of ground.
- (4) casing steel (material), \_\_\_\_\_ (depth),  
12" (size) if telescope see back.
- (5) screen 40' (length), \_\_\_\_\_ (depth to top),  
12" (size), \_\_\_\_\_ (material)
- (6) pump 40 (HP), \_\_\_\_\_ (yield gpm)  
Gear (type power)
- (7) electric log No (yes or no)  
None (organization running log)
- (8) how well bottom plugged Plug

| description of formations encountered | from | to  |
|---------------------------------------|------|-----|
| Clay                                  | 0    | 28  |
| Fine Sand                             | 28   | 58  |
| Sand + gravel                         | 58   | 68  |
| M. sand + gravel                      | 68   | 70  |
| Fine Sand                             | 70   | 75  |
| Sand + Gravel                         | 75   | 105 |

RECEIVED


JUN 06 1988

Department of Natural Resources  
Bureau of Land & Water Resources

DRILLERS REMARKS:

If well telescopes please sketch and show depths.

GROUND LEVEL

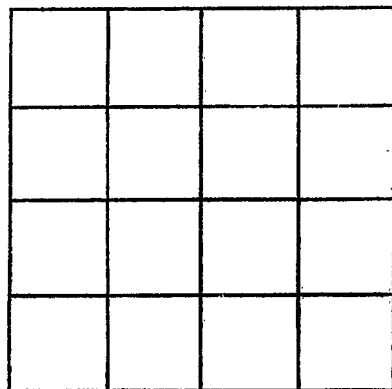

SECTION \_\_\_\_\_

Please indicate well location X.

ADDITIONAL INFORMATION

If more than one screen,  
show locations of each on sketch.