

MISSISSIPPI DEPARTMENT OF NATURAL RESOURCES

Bureau of Land and Water Resources

Southport Mall

P.O. Box 10631

Jackson, Mississippi 39209

WATER WELL DRILLERS LOG

Permit Applied For
C 63

Coded

5-3 1988
date well completed

88 Dyer Well
firm name

Washington
county well located

LANDOWNER: Hill Farms

description of formations encountered

from

to

Rt 2 Box 340

Clay

0 28

Indianola Ms.

Loam Sand

28 68

(mailing address)

Sand & Gravel

68 105

WELL LOCATION:

sec. 12 T. 19 N. R. 6 E

15 miles NW of Indianola
(distance) (direction) (nearest town)

WELL PURPOSE: irrigation
(home, irrigation, municipal, industrial)

WELL COMPLETION DATA:

(1) diameter (inches) 12"

(2) total depth (feet) 105'

(3) static water level (feet) _____ below
top of ground: above

(4) casing steel _____
(material) (depth)

12" if telescope see back.
(size)

(5) screen 40' _____
(length) (depth to top)

12" _____
(size) (material)

(6) pump 40 _____
(HP) (yield gpm)

Gear
(type power)

(7) electric log No
(yes or no)

None
(organization running log)

(8) how well bottom plugged Plate

RECEIVED


JUN 06 1988

Department of Natural Resources
Bureau of Land and Water Resources

DRILLERS REMARKS:

If well telescopes please sketch and show depths.

GROUND LEVEL

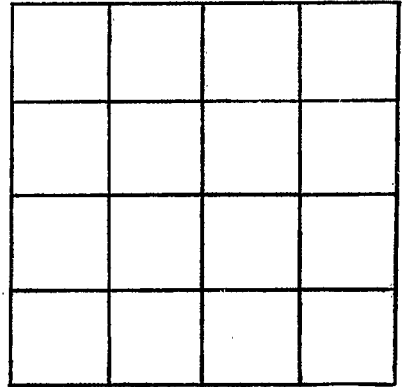

SECTION _____

Please indicate well location X.

ADDITIONAL INFORMATION

If more than one screen,
show locations of each on sketch.